

SURVEY & RE-MONUMENTATION

OCT 31 1994

COMMISSION

LAND CORNER RECORDATION CERTIFICATE
Filing Requirement of Act 74, Mich. P.A. 1970

For corners in

<u>MANISTEE</u> (County)	Located In:	Corner Code #
1. Public Land Survey	T <u>22N</u> R <u>14W</u>	D-6
	T _____ R _____	_____
	T _____ R _____	_____
	T _____ R _____	_____
2. Property Controlling in Section	S _____ T _____ R _____	_____
	S _____ T _____ R _____	_____
3. Miscellaneous Property in Sec.	S _____ T _____ R _____	_____
	S _____ T _____ R _____	_____
4. Lot No. _____, Recorded Plat _____		
5. Private Claims _____		

REGISTER'S OFFICE
 MANISTEE COUNTY
 #94-313 AT 3:20 P.M.
 JUL 11 1994
Penny A. Peever
 REGISTER OF DEEDS

Register of Deeds Stamp & File Number

	A	B	C	D	E	F	G	H	I	J	K
2	6		5		4		3		2		
3											
4	7		8		9		10		11		
5											
6	18		17		16		15		14		
7											
8	19		20		21		22		23		
9											
10	30		29		28		27		26		
11											
12	31		32		33		34		35		

I, Kenneth L. Ross, in a field survey on JUNE, 1994, do hereby certify that under requirements of P.A. 74, Michigan P.A. of 1970, the corner points mentioned in lines 1 and 2 above were in conformance with regulations and rules therefore as required in the current manual of survey instructions of the United States Department of the Interior, Bureau of Land Management or by a decree of a Court of Law and/or that the corner points mentioned in lines 3, 4 and 5 above were in conformance with the rules of the Michigan Board of Land Surveyors or by a Decree of a Court of Law; established, re-established, monumented, re-monumented, recovered, found as expressed below:

NOTE: Not more than 4 corners, all in the same town and range, may be recorded on this certificate.


A. Description of original monument and accessories and/or subsequent restoration:
 D-6 Center 1/4 Corner, Sec. 17
 Nothing set on original survey

B. Description of corner evidence found and/or method applied in restoring or reestablishing corner:
 D-6 Center 1/4 Corner, Sec. 17
 1994 Ross Rd 1/2" X 18" Rebar set by Clint Cole
 24" under surface, also Pd 1 1/4" pipe of undetermined length under rebar
 3 surveys recorded with Register of Deeds & work sheet of Clint Cole showing layout of NB 1/4

C. Description of monument for corner and accessories established to perpetuate locating the position of the corner:
 D-6 Center 1/4 Corner, Sec. 17
 Replaced 1/2" X 18" rebar with standard Manistee County monument at road centerline, and is accepted as the best available evidence of the original corner.
 P. Pole N 74 W 116.03'
 12" Red Oak N 79 E 114.97'
 7" W. Pine S 43 E 126.80'
 6" W. Pine S 44 W 41.19'
 Pd 1 1/4" Iron of unknown length under rebar 24" deep, left in place

Signed by *Kenneth L. Ross*
 Surveyor's Michigan License No. 17634

Date July 11, 1994

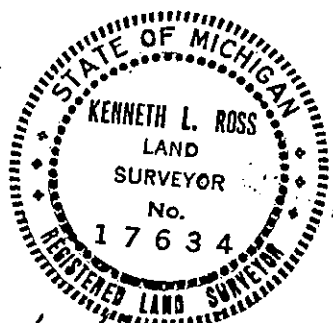

Corner D-6 ratified by the Manistee County Peer Group according to the county plan adopted pursuant to P.A. 345 of 1990, as amended, (being the State Survey and Re-monument Act, MCL 54.261 et. seq.). Date of Peer Review: July 11, 1994
Bessie J. Jernigan
 REGISTERED LAND SURVEYOR
APPROVED JUL 11 1994