

**SURVEY &
REMONUMENTATION**

DEC 09 1999

SECTION

LAND CORNER RECORDATION CERTIFICATE

Filing Requirement of Act 74, Mich. P.A. 1970

For corners in <u>MANISTEE</u> (County)	Located In:	Corner Code #
1. Public Land Survey	T 22N R 14 W	M-6
	T _____ R _____	_____
	T _____ R _____	_____
	T _____ R _____	_____
2. Property Controlling in Section	S _____ T _____ R _____	_____
	S _____ T _____ R _____	_____
3. Miscellaneous Property in Sec.	S _____ T _____ R _____	_____
	S _____ T _____ R _____	_____
4. Lot No. _____, Recorded Plat _____		
5. Private Claims _____		

**REGISTER'S OFFICE
MANISTEE COUNTY**
99-253 at 4:25pm
AUG 12 1999
Deborah Dix
REGISTER OF DEEDS

Register of Deeds Stamp & File Number

	A	B	C	D	E	F	G	H	I	J	K	L
1												
2	6		5		4		3		2		1	
3												
4	7		8		9		10		11		12	
5												
6	18		17		16		15		14		13	
7												
8	19		20		21		22		23		24	
9												
10	30		29		28		27		26		25	
11												
12	31		32		33		34		35		36	
13												

I, Sammy S. Barnett, in a field survey on July 6th 19 99, do hereby certify that under requirements of P.A. 74, Michigan P.A. of 1970, the corner points mentioned in lines 1 and 2 above were in conformance with regulations and rules therefore as required in the current manual of survey instructions of the United States Department of the Interior, Bureau of Land Management or by a decree of a Court of Law and/or that the corner points mentioned in lines 3, 4 and 5 above were in conformance with the rules of the Michigan Board of Land Surveyors or by a Decree of a Court of Law; established, re-established, monumented, re-monumented, recovered, found as expressed below:

NOTE: Not more than 4 corners, all in the same town and range, may be recorded on this certificate.

A. Description of original monument and accessories and/or subsequent restoration:
M - 6 East one-quarter corner of section 13 T22N, R14W

- | | |
|---|---|
| 1837 GLO survey by John Brink, set post
1 W. Pine 16" S22 1/2W 13 lks (8.58')
2 W. Pine 14" N38 1/2W 23 lks (15.18') | 1925 Road survey by Muecchester, Iron rail, about 35 lb.
Book B Page 116, corner previously established by J. Millard
5 W. Pine stump 28" South 12.5' |
| 1900 survey by J Millard, Book A page 94
mon. not given
3 W. Pine 14" N40W 39 lks (25.74')
4 W. Pine 15" N39E 40 lks (26.4') | No date, Manistee Co. Rd. Comm., 1" pipe
6 Power pole NW (ch3/163 A/13) 47.21'
7 Oak 20" SW (blazed) 48.96'
8 Oak 20" SE (blazed) 60.38' |
- 1902 survey by Knight, mon. not given, established by Millard


B. Description of corner evidence found and/or method applied in restoring or reestablishing corner:

M - 6 East one-quarter corner of section 13 T22N, R14W
On July 7th 1999, I found a 1" x 18" pipe in the centerline of a E-W blacktop road and in the centerline of a gravel road to the south, condition of the witnesses are as follows.
Gone # 1, # 2, # 3, # 4, # 5, # 7 & # 8, found in good condition # 6

C. Description of monument for corner and accessories established to perpetuate locating the position of the corner:

M - 6 East one-quarter corner of section 13 T22N, R14W
On July 7th. 1999, I accepted the found 1" x 18" pipe as the best available evidence of the position of the original corner, and replaced it, in the exact location, with a standard Manistee Co. mon. stamped to identify the corner, in mon. box, and took the following witnesses.
6 Power pole N35W 47.03' fd. nail & shiner in NW side
9 Oak 14" Twin S33W 39.25' fd. 60d spike in NW side
10 Oak 20" S35E 49.20' fd. 60d spike in SW side
11 Oak 14" N38E 64.82' fd nail set 60d spike in SE side
12 1" Pipe N04E 50.53'

Corner M-06 ratified by the Manistee County Peer Group according to the county plan adopted pursuant to P.A. 345 of 1990, as amended, (being the State Survey and Remonument Act, MCL 54.261 et. seq.). Date of Peer Review: Arthur M. Slawinski
AUG 03 1999

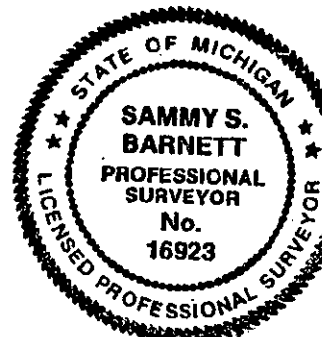

Signed by Sammy S. Barnett Date 8/1/99
Surveyor's Michigan License No. P S # 16923