

LAND CORNER RECORDATION CERTIFICATE
FILING REQUIREMENT OF ACT 74, MICH. P.A.1970

FOR CORNERS OF-- LOCATED IN-- CORNER CODE NUMBER
1. PUBLIC LAND SURVEY... T. 22 N. R. 16 W. A-7; A-8
2. PROPERTY CONTROLLING IN SECTION 19, T. 22 N. R. 16 W. Code 4
3. MISCELLANEOUS PROPERTY IN SECTION... T. N. S., R. E. W.
4. LOT NO. ... RECORDED PLAT
5. PRIVATE CLAIMS

REGISTER OF DEEDS STAMP AND FILING NUMBER

I, Carl F. Roser do hereby certify that under requirements of P.A. 74, Michigan P.A. of 1970 the corner points mentioned in lines 1 and 2 above (identified with circles on index code diagram-over) were, in a field survey on 3-16 1973, established, re-established, monumented, re-monumented, recovered or restored as expressed below and in conformance with regulations and rules therefore as required in the current manual of survey instructions of the United States Department of the Interior, Bureau of Land Management or by a decree of a court of law.

A. Description of original monument and accessories and/or subsequent restoration:


B. Description of corner evidence found and/or method applied in restoring or re-establishing corner:

- A-7 Fd. concrete monument. Used by RLS Bill Batzer on survey for Lakeshore Haven Subdn.
A-8 Fd. 1 1/2" pipe. Fits J. H. Millard survey of record, dated 1926.
Code 4 At SW corner of Govt Lot 2, found 1/2" pipe and two witnesses from survey of record by J. H. Millard, dated April 17, 1926

C. Description of monument for corner and accessories established to perpetuate locating the position of the corner:

Table with 3 columns: A-7, A-8, Code 4. Rows list monument types and measurements: Found Concrete Monument, Found 1 1/2" pipe, Found 1/2" pipe.

SIGNED BY Carl F. Roser DATE 6-15-73
SURVEYOR'S MICHIGAN REGISTRATION NO. 12028
FOR STATE AND UNITED STATES AGENCIES:
SIGNED BY CHIEF OF SURVEY PARTY DATE
APPROVED AND SIGNED BY MICHIGAN REGISTERED LAND SURVEYOR DATE

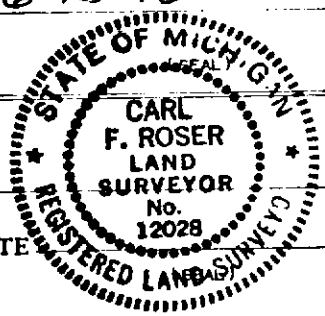

SURVEYOR'S MICHIGAN REGISTRATION NO.