

LAND CORNER RECORDATION CERTIFICATE
 Filing Requirement of Act 74, Mich. P.A. 1970

For corners in

MANISTEE
 (County)

Located In:

Corner Code: #

- | | | |
|---------------------------------------|----------------------------|------------|
| 1. Public Land Survey | T <u>22N</u> R <u>R16W</u> | <u>E-5</u> |
| | T _____ R _____ | _____ |
| | T _____ R _____ | _____ |
| | T _____ R _____ | _____ |
| 2. Property Controlling in Section | S _____ T _____ R _____ | _____ |
| | S _____ T _____ R _____ | _____ |
| 3. Miscellaneous Property in Sec. | S _____ T _____ R _____ | _____ |
| | S _____ T _____ R _____ | _____ |
| 4. Lot No. _____, Recorded Plat _____ | | |
| 5. Private Claims _____ | | |


**REGISTER'S OFFICE
 MANISTEE COUNTY**

95-350 at 1:25 pm

SEP - 7 1995

Deborah Six Dep.
REGISTER OF DEEDS

Register of Deeds Stamp & File Number

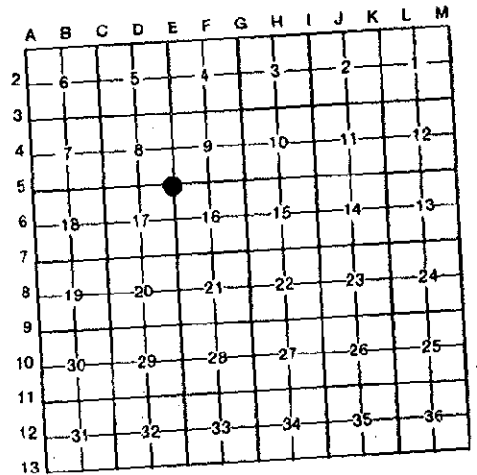


I, John Schulke, in a field survey on July 19, 1995, do hereby certify that under requirements of P.A. 74, Michigan P.A. of 1970, the corner points mentioned in lines 1 and 2 above were in conformance with regulations and rules therefore as required in the current manual of survey instructions of the United States Department of the Interior, Bureau of Land Management or by a decree of a Court of Law and/or that the corner points mentioned in lines 3, 4 and 5 above were in conformance with the rules of the Michigan Board of Land Surveyors or by a Decree of a Court of Law; established, re-established, monumented, re-monumented, recovered, found as expressed below:

NOTE: Not more than 4 corners, all in the same town and range, may be recorded on this certificate.

- A. Description of original monument and accessories and/or subsequent restoration:
 In 1839, J. Brink set a wood post at the corner with the following corner references:
 Beech 11" S28°W 42 lks.
 Beech 12" N40°E 53 lks.
- In 1848, B.O. Risdon (Deputy Surveyor) found no evidence of the 1839 survey, he set a wood post at the corner by measuring from the South. The following corner references:
 1. Cedar 12" N67°E 27 lks.
 2. Cedar 14" S68°W 34 lks.
- In 1910, E. W. M. (see Book A, page 146 in the Manistee Co. Register of Deed's Office) used corner to subdivide Northwest Quarter of Section 16. No ties or monument listed.
 Undated, Manistee Co. Road Commission record indicate an iron pipe at the corner. The following corner references:
 3. Pine NW 48.40 ft.
 4. Power Pole NE 91.29 ft.
 5. Power Pole SE 69.92 ft.
- In 1974, L. Gershbacher found 1/2" iron pipe (see LCRC 74-10 in the Manistee Co. Register of Deed's Office). The following corner references:
 6. Power Pole N15°E 93.50 ft.
 7. Cedar 7" N33°W 49.17 ft.
- In 1977, T. O'Brien found 3/4" pipe (see LCRC 77-20 in the Manistee Co. Register of Deed's Office). The following corner references:
 8. Cedar 6" N31°W 49.2 ft.
 9. Power Pole N12°E 93.6 ft.
 10. Anchor S70°E 70.8 ft.
- B. Description of corner evidence found and/or method applied in restoring or reestablishing corner:
 In 1994, Found a cabin spike at the intersection of Bar Lake Rd. and Schoedel Road.
 In July 1995, found cabin spike used as a riser in a 1/2"x24" pipe on center line of Bar Lake Road. 1 ft. South of center line of Schoedel road running East. Recovered 7 (8) and 10. References 1, 2, 3, 4, 5, 6, and 9 were not recovered. Distance to corners and occupations:
 E-4 (East 1/4 corner of Section 8) 2656.62 ft. Schulke
 Tree line running North at the West 1/16th corner of Sections 9 and 16. 1274.7 ft.
 F-5 (South 1/4 corner of Section 9) 2650.12 ft.
 E-6 (East 1/4 corner of Section 17) 2638.77 ft. Schulke
 D-5 (South 1/4 corner of Section 8) 2638.03 ft. O'Brien
 D-4 (Southeast corner of Section 7) 5276.06 ft. O'Brien

C. Description of monument for corner and accessories established to perpetuate locating the position of the corner:
 Accepting the recovered cabin spike and pipe to be in the perpetuated location of the government corner, I replaced said evidence with a 2" dia. X30" galvanized pipe monument with a brass cap stamped to identify the corner in a monument box. The following corner references:
 7. & 8. Cedar (clump) 12" N23°W 51.80 ft.
 10. Eye of Anchor S50°E 70.76 ft.
 for Guy line now abandoned N52°E 44.32 ft.
 11. Power Pole N33°W 43.98 ft.
 12. Brace Pole 7" S55°E 74.54 ft.
 13. Balsam S04°E 193.24 ft.
 14. Power Pole

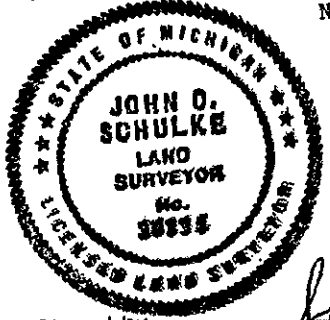

NOTE: 60-D nail's placed in Cedar & Balsam trees.

Corner E-5 ratified by the Manistee County Peer Group according to the county plan adopted pursuant to P.A. 345 of 1990, as amended, (being the State Survey and Remonument Act, MCL 54.261 et. seq.). Date of Peer Review: *Catrick K. Perry*

SEP 5 1995

Signed by John C. Schulke Date July 31, 1995

Surveyor's Michigan License No. RLS-30894