

**LAND CORNER RECORDATION CERTIFICATE**  
**Filing Requirement of Act 74, Mich. P.A. 1970**

For corners in  
**MANISTEE**

(County)

Located In:

Corner Code #

- |                                    |         |                 |       |
|------------------------------------|---------|-----------------|-------|
| 1. Public Land Survey              |         | T 22N R 16W     | G-13  |
|                                    |         | T 23N R 16W     | G-13  |
|                                    |         | T _____ R _____ | _____ |
|                                    |         | T _____ R _____ | _____ |
| 2. Property Controlling in Section | S _____ | T _____ R _____ | _____ |
|                                    | S _____ | T _____ R _____ | _____ |
| 3. Miscellaneous Property in Sec.  | S _____ | T _____ R _____ | _____ |
|                                    | S _____ | T _____ R _____ | _____ |

REGISTER'S OFFICE  
 MANISTEE COUNTY

#94-287 At 4:20 p.m.

JUN 23 1994

*Remmy A. Pepone*  
 REGISTER OF DEEDS

Register of Deeds Stamp & File Number

4. Lot No. \_\_\_\_\_, Recorded Plat \_\_\_\_\_  
 5. Private Claims \_\_\_\_\_

	A	B	C	D	E	F	G	H	I	J	K	L	M
2	6	5	4	3	2								
3													
4	7	8	9	10	11	12							
5													
6	18	17	16	15	14	13							
7													
8	19	20	21	22	23	24							
9													
10	30	29	28	27	26	25							
11													
12	31	32	33	34	35	36							
13													

I, Richard L. Hays, in a field survey on Sept. 10, 1993, do hereby certify that under requirements of P.A. 74, Michigan P.A. of 1970, the corner points mentioned in lines 1 and 2 above were in conformance with regulations and rules therefore as required in the current manual of survey instructions of the United States Department of the Interior, Bureau of Land Management or by a decree of a Court of Law and/or that the corner points mentioned in lines 3, 4 and 5 above were in conformance with the rules of the Michigan Board of Land Surveyors or by a Decree of a Court of Law; established, re-established, monumented, re-monumented, recovered, found as expressed below:

**NOTE: Not more than 4 corners, all in the same town and range, may be recorded on this certificate.**

**A. Description of original monument and accessories and/or subsequent restoration:**

<b>G-13 SECTION CORNER COMMON TO SECTIONS 33 &amp; 34, T23N,R16W &amp; SECTIONS 3 &amp; 4, T22N,R16W</b>	<b>1839:G.L.O. Boundary of T23N, R16W</b>	<b>1899:Millard Survey-Found old Stake set Stone &amp; Plow Point</b>	<b>1991:Jack Pierson Survey Recorded L.C.R.C.# 91-175</b>
10" Beech N-67½-E 50 Lks			10" Birch S-30°-W 64.05'
11" Beech N-80½-W 30 Lks	<b>1980:Anthony Slawinski Survey Section Subdivision of T22N, R16W</b>	<b>Fd Iron &amp; Stone Replaced with 1 1/4" Iron Pipe</b>	14" Maple S-65°-W 34.06'
16" Beech S-29°-E 10 Lks		8" Tw. Maple S-60°-W 34.10'	Power Pole S-30°-E 60.20'
10" Beech S-77°-W 71 Lks		Power Pole S-30°-E 60.52'	Sign Post N-67°-E 18.14'


**B. Description of corner evidence found and/or restored applying to reestablishing corner:**

**G-13 SECTION CORNER COMMON TO SECTIONS 33 & 34, T23N,R16W & SECTIONS 3 & 4, T22N,R16W**  
 1994:Found 1 1/4" Iron Pipe and found the Witnesses of the Anthony Slawinski and the Jack Pierson Survey

**C. Description of monument for corner and accessories established to perpetuate locating the position of the corner:**

**G-13 SECTION CORNER COMMON TO SECTIONS 33 & 34, T23N,R16W & SECTIONS 3 & 4, T22N,R16W**  
 Replaced 1 1/4" Iron Pipe with the Standard Manistee County Monument with Brass Cap in a Monument Box, as a careful and faithful perpetuation of the position of the Original Corner.

Power Pole	S-30°-E	62.26'
14" Maple	S-62°-30"-E	34.06'
12" Popular	N-14°-W	94.66'
10" Birch	S-30°-W	64.01'
Centerline of Miller Rd	West	1.60'

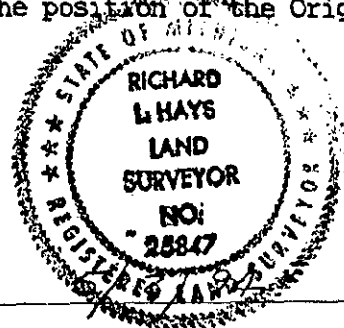

Signed by Richard Hays  
 Surveyor's Michigan License No. 25847

Date \_\_\_\_\_

Corner G-13 ratified by the Manistee County Peer Group according to the county plan adopted pursuant to P.A. 345 of 1990, as amended, (being the Static Survey and Reassignment Act, MCL 54.261 et seq.). Date of Peer Review: 5/14/94 *Richard R. Young*