

LAND CORNER RECORDATION CERTIFICATE
Filing Requirement of Act 74, Mich. P.A. 1970

For corners in

MANISTEE

(County)

Located in: _____ Corner Code # _____

T	R	K-13
T	R	T22N
T	R	R17W
S	T	R
S	T	R
S	T	R
S	T	R
S	T	R
S	T	R
S	T	R

REGISTER'S OFFICE
 MANISTEE COUNTY

94-285 AT 4:15 p.m.

JUN 23 1994

Ronny A. Payne
 REGISTER OF DEEDS

1. Public Land Survey

2. Property Controlling in Section

3. Miscellaneous Property in Sec.

Register of Deeds Stamp & File Number

4. Lot No. _____, Recorded Plat _____
 5. Private Claims _____

	A	B	C	D	E	F	G	H	I	J	K	L	M
2	6	5	4	3	2	1							
3													
4	7	8	9	10	11	12							
5													
6	18	17	16	15	14	13							
7													
8	19	20	21	22	23	24							
9													
10	30	29	28	27	26	25							
11													
12	31	32	33	34	35	36							
13													

I, Richard L. Hays, in a field survey on April 20, 1994, do hereby certify that under requirements of P.A. 74, Michigan P.A. of 1970, the corner points mentioned in lines 1 and 2 above were in conformance with regulations and rules therefore as required in the current manual of survey instructions of the United States Department of the Interior, Bureau of Land Management or by a decree of a Court of Law and/or that the corner points mentioned in lines 3, 4 and 5 above were in conformance with the rules of the Michigan Board of Land Surveyors or by a Decree of a Court of Law; established, re-established, monumented, re-monumented, recovered, found as expressed below:

NOTE: Not more than 4 corners, all in the same town and range, may be recorded on this certificate.

A. Description of original monument and accessories and/or subsequent restoration:

K-1 SECTION CORNER COMMON TO SECTIONS 1 & 2, T21N, R17W & SECTIONS 35 & 36, T22N, R17W
 1839 G.L.O: 12" White Pine N-52°-E 113 Links
 12" White Pine N-77½°-W 77 Links

1989: BRUCE JENEMA SURVEY 1990: PLAT OF MANISTEE INDUSTRIAL PARK
 6" Oak S-50°-W 15.53'
 Fire Hyd S-15°-W 119.60'
 N. Gate Post S-35°-E 77.13'
 Fence Line East 50.12'

B. Description of corner evidence found and/or method applied in restoring or reestablishing corner:

K-1 SECTION CORNER COMMON TO SECTIONS 1 & 2, T21N, R17W & SECTIONS 35 & 36, T22N, R17W
 1994: Found 1 1/4" Iron Pipe and the Jenema Witnesses and the plat information.

Number K-13 ratified by the Manistee County Peer Group according to the county plan adopted pursuant to P.A. 345 of 1990, as amended, (being the State Survey and Reestablishment Act, MCL 54.261 et seq.) Date of Peer Review: JUN 6 1994


C. Description of monument for corner and accessories established to perpetuate locating the position of the corner:

K-1 SECTION CORNER COMMON TO SECTIONS 1 & 2, T21N, R17W & SECTIONS 35 & 36, T22N, R17W
 Replaced the 1 1/4" Iron Pipe with the Standard Manistee County Monument with Brass Cap and is accepted as a careful and faithful re-establishment of the Original Corners

9" Oak	S-50°-W	14.30'
Light Pole	S-08°-W	219.33'
Centerline Gate Post	S-40°-E	77.13'
SW Cor. Shed	N-10°-E	249.62'

Signed by Richard L. Hays

Surveyor's Michigan License No. 25847

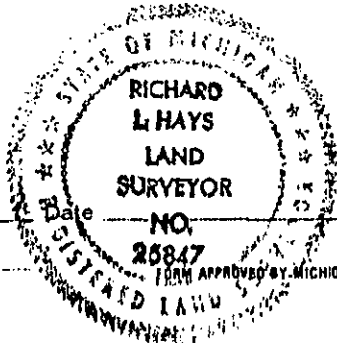

5/3/94