LAND CORNER RECORDATION CERTIFICATE

Filing Requirement of Act 74, Mich. P.A. 1970

For corners in

Manistee (County)

	Located In:	Corner Code #
1. Public Land Survey	T 22N R 17W	M-12
	T___ R___	East ¼ Cor.
	T___ R___	Sec. 36
	T 22N R 16W	A-12
2. Property Controlling	S___ T___ R___	West ¼ Cor.
in Section	S___ T___ R___	Sec. 31
3. Miscellaneous	S___ T___ R___	
Property in Sec.	S___ T___ R___	

4. Lot No. _____, Recorded Plat _____
5. Private Claims _____

REGISTER'S OFFICE
MANISTEE COUNTY
98-339 at 9:00am
JUN 29 1998
Kathleen Lux
REGISTER OF DEEDS

Register of Deeds Stamp & File Number

I, Anthony M. Slawinski, in a field survey on June 10, 19 98 do hereby state that under requirements of P.A. 74, Michigan P.A. of 1970, the corner points mentioned in lines 1 and 2 *above were in conformance with regulations and rules therefore as required in the current manual of* survey instructions of the United States Department of the Interior, Bureau of Land Management or by a decree of a Court of Law and /or that the corner points mentioned in lines 3, 4 and 5 above were in conformance with the rules of the Michigan Board of Land Surveyors or by a Decree of a Court of Law; established, re-established, monumented, recovered, found as expressed below:

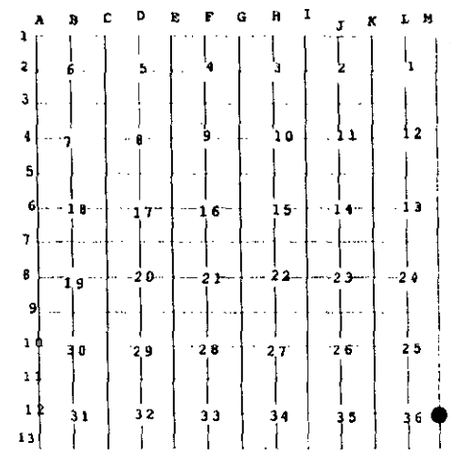

NOTE: Not more than 2 corners, all in the same town and range, may be recorded on this certificate.

A. Description of original monument and accessories and/or subsequent restoration:

Set by John Brink 1837
1. *Black Oak 9" N 41° W 36 links* *(Gone)*
2. White Pine 18" S 20° W 62 links (Gone)

B. Description of corner evidence found and/or method applied in restoring or *reestablishing corner:*

Information Referenced:

Oakfield Subdivision
(8-6-1881) Liber 2, Page 26

Sibley's Addition to the Village of Parkdale
(4-3-30) Liber 4, Pages 4&5
Ager Subdivision
(7-11-57) Liber 4, Page 31

U.S.-31 Right of Way Map

Field Notes by Slawinski
found ½" iron rod
3. NW 35.16' Fence Post (Gone)
4. SWW 38.74' 5" Maple (Good)
5. NE 47.79' Power Pole (Gone)
6. NW 47.91' 10" Maple (Gone)

Field Notes by Abonmarche (1998)

Survey Certificate by Ross (1995)

On March 20, 1998, I, Anthony Slawinski, Along with Abonmarche, Found a spike in the approximate center line of Hill Road.

C. Description of monument for corner and accessories established to perpetuate locating the position of the corner:

On June 10, 1998, I installed a Manistee County Monument, within a monument box, in the exact location of the above mentioned spike, as a careful and faithful re-establishment of the location of the original corner, and witnessed by:

4. S 82° W 38.56' 18" Twin Maple, 60D spike in the South side
7. S 48° E 36.00' Power Pole, 60D spike in the South side
8. S 30° W 8868' 18" White Oak, 60D spike in the East side
9. S 58° W 43.63' 12" White Pine, 60D spike in the Southeast side

Note: South 1321.84 feet to the South 1/16th Corner on the East Section Line of Section 36, T22N., R17W. Corner is ±1100' North from the center line of Highway U.S. - 31.

Corner _ _ _ _ ratified by the Manistee County Peer Group according to the county plan adopted pursuant to P.A. 345 of 1990, as amended, (being the State Survey and Remonument Act, MCL 54.261 et seq.). Date of Peer Review: JUN 0 2 1998

STATE OF MICHIGAN
ANTHONY M. SLAWINSKI
SURVEYOR NO. 13597
REGISTERED LAND SURVEYOR

Signed by Anthony M. Slawinski Date 6-26-98

Surveyor's Michigan License No. 13597

FORM APPROVED BY MICHIGAN STATE BOARD OF PROFESSIONAL SURVEYORS, JAN. 28, 1971
REVISED MAY 14, 1975
REVISED JAN., 1983
REVISED OCT., 1995