

1993

LAND CORNER RECORDATION CERTIFICATE
Filing Requirement of Act 74, Mich. P.A. 1970

COMMISSION

For corners in
Manistee

(County)

Located In:

Corner Code #

M-8 T22N R15W
A-8

M-8

REGISTER'S OFFICE
MANISTEE COUNTY

FEB 2 1993

NO. 93-40 AT 9:00 A.M.
REGISTER OF DEEDS
Register of Deeds Stamp & File Number

- 1. Public Land Survey T 22N R 14W
T _____ R _____
T 22N R 15W
T _____ R _____
- 2. Property Controlling S _____ T _____ R _____
in Section S _____ T _____ R _____
- 3. Miscellaneous S _____ T _____ R _____
Property in Sec. S _____ T _____ R _____

- 4. Lot No. _____, Recorded Plat _____
- 5. Private Claims _____

I, Robert F. Mitchell in a field survey on August, 19 92, do hereby certify that under requirements of P.A. 74, Michigan P.A. of 1970, the corner points mentioned in lines 1 and 2 above were in conformance with regulations and rules therefore as required in the current manual of survey instructions of the United States Department of the Interior, Bureau of Land Management or by a decree of a Court of Law and/or that the corner points mentioned in lines 3, 4 and 5 above were in conformance with the rules of the Michigan Board of Land Surveyors or by a Decree of a Court of Law; established, re-established, monumented, re-monumented, recovered, found as expressed below:

NOTE: Not more than 4 corners, all in the same town and range, may be recorded on this certificate.

A	B	C	D	E	F	G	H	I	J	K	L	M
2	6	5	4	3	2	1						
3												
4	7	8	9	10	11	12						
5												
6	18	17	16	15	14	13						
7												
8	19	20	21	22	23	24						
9												
10	30	29	28	27	26	25						
11												
12	31	32	33	34	35	36						
13												

A. Description of original monument and accessories and/or subsequent restoration:

A-8; West One-quarter Corner Section 19; Originally established during U.S. Survey conducted by J. Brink in 1837. Brink found the corner position occupied by a 13" Elm and noted no accessories. During the course of a survey conducted in December 1900, J. Millard, Manistee County Surveyor found and accepted a "notched and scarred Elm on (a) blazed line" as the corner. Millard also established the 1/16th corner to the north. The minutes of this survey are recorded in Book "B" pp. 54-55 of the Manistee County Surveyor Records.


B. Description of corner evidence found and/or method applied in restoring or reestablishing corner:

A-8; West One-quarter Corner Section 19; Found no evidence of Elm remains nor of Millard's witnesses to such. However a charred stake point in agreement with all three of Millard's witnesses of 1900 was found at the 1/16th corner position. Re-established the quarter corner position by doubling over Millard's 1/16th corner and monumenting it with a 2" x 30" galvanized pipe with 3" brass cap.

C. Description of monument for corner and accessories established to perpetuate locating the position of the corner:

A-8; West One-quarter Corner Section 19;
Set a 2"x 30" galv. pipe w/ 3" brass cap flush with the ground.

- North-Intersection West Line Sec. 19 & Indian Reserve Line-137.06'
- N25°E - 9" Black Ash - 35.71'
- S14°E - 8" Black Ash - 35.18'
- S55°W - 17" Red Maple - 30.32'
- N32°W - 10" Black Ash - 37.22'
- South - thread of Bear Creek - 410'
- North - carsonite post - 1.0'

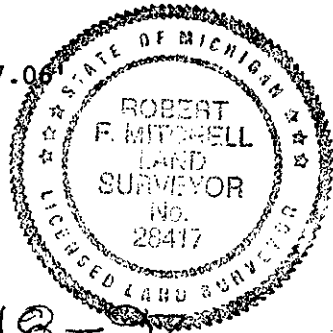

Signed by [Signature]

Date 9-18-92

Surveyor's Michigan License No. 28417

Corner M-8 certified by the Manistee County Peer Group pursuant to P.A. 123 of 1915, as amended by P.A. 345 of 1990, as amended. Date of Peer Review: JAN - 4 1993