

**SURVEY & REMONUMENTATION**

DEC 09 1999

**LAND CORNER RECORDATION CERTIFICATE**  
Filing Requirement of Act 74, Mich. P.A. 1970

**SECTION**

For corners in

MANISTEE  
(County)

Located In:

Corner Code #

1. Public Land Survey

T 23 NR 14 W

T 23 NR 13 W

T \_\_\_\_\_ R \_\_\_\_\_

T \_\_\_\_\_ R \_\_\_\_\_

2. Property Controlling in Section


S \_\_\_\_\_ T \_\_\_\_\_ R \_\_\_\_\_

S \_\_\_\_\_ T \_\_\_\_\_ R \_\_\_\_\_

3. Miscellaneous Property in Sec.

S \_\_\_\_\_ T \_\_\_\_\_ R \_\_\_\_\_

S \_\_\_\_\_ T \_\_\_\_\_ R \_\_\_\_\_

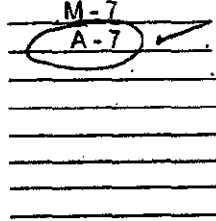

REGISTER'S OFFICE  
MANISTEE COUNTY

99-249 at 4:05 pm  
AUG 12 1999

*Beborah Six*  
REGISTER OF DEEDS

Register of Deeds Stamp & File Number

4. Lot No. \_\_\_\_\_, Recorded Plat \_\_\_\_\_.

5. Private Claims \_\_\_\_\_.

I, Sammy S. Barnett, in a field survey on JUNE 14TH 19 99, do hereby certify that under requirements of P.A. 74, Michigan P.A. of 1970, the corner points mentioned in lines 1 and 2 above were in conformance with regulations and rules therefore as required in the current manual of survey instructions of the United States Department of the Interior, Bureau of Land Management or by a decree of a Court of Law and/or that the corner points mentioned in lines 3, 4 and 5 above were in conformance with the rules of the Michigan Board of Land Surveyors or by a Decree of a Court of Law; established, re-established, monumented, re-monumented, recovered, found as expressed below:

NOTE: Not more than 4 corners, all in the same town and range, may be recorded on this certificate.

	A	B	C	D	E	F	G	H	I	J	K	L	M
1													
2	6	5	4	3	2	1							
3													
4	7	8	9	10	11	12							
5													
6	18	17	16	15	14	13							
7													
8	19	20	21	22	23	24							
9													
10	30	29	28	27	26	25							
11													
12	31	32	33	34	35	36							
13													

A. Description of original monument and accessories and/or subsequent restoration:

M- 7 Corner common to section 13 & 24 T23N, R14W & section 18 & 19 T23N, R13W

1838 GLO survey by John Brink, set post  
# 1 Hemlock 14" S38W 62 lks (40.92')  
# 2 Hemlock 10" N50W 23 lks (15.18')

1986 survey by A.M. Slawinski reset 1 1/4" pipe from witnesses  
# 3 Power pole East 34.31'  
# 4 W. Pine 20" N35W 95.38'  
# 5 top of tele. 4x4 S70W 34.50'

B. Description of corner evidence found and/or method applied in restoring or reestablishing corner:

M- 7 Corner common to section 13 & 24 T23N, R14W & section 18 & 19 T23N, R13W

On July 7th 1999 I found the 1 1/4" pipe that was re-set from witnesses by A.M. Slawinski, the condition of the witnesses are as follows.  
Gone # 1 & # 2 found # 3, # 4 & # 5

C. Description of monument for corner and accessories established to perpetuate locating the position of the corner:

M- 7 Corner common to section 13 & 24 T23N, R14W & section 18 & 19 T23N, R13W


On July 7th 1999, I replaced in the exact location the found 1 1/4" pipe with a standard Manistee Co. Mon. stamped to identify the corner & accepted this location as a careful and faithful re-establishment of the position of the original corner, and took the following witnesses.

# 3 Power pole # BR1/147 East 34.15' fd. nail & shiner in E. side  
# 4 W. Pine N38W 95.34' fd. nail & shiner, set 60d spike NE side  
# 5 Top of tele. 4 x 4 S74W 34.51' fd. nail & shiner in top  
# 6 Power pole # BR1/147/1 N88W 36.70' fd. nail & shiner in N. side

Corner M-07

ratified by the Manistee County Peer Group according to the county plan adopted pursuant to P.A. 345 of 1990, as amended, (being the State Survey and Re-monument Act, Mich. 54.261 et. seq.). Date of Peer Review: Anthony M. Slawinski

AUG 03 1999

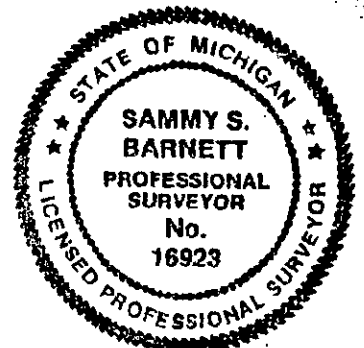

Signed by Sammy S. Barnett

Date 8/1/99

Surveyor's Michigan License No. PS # 16923