

**SURVEY &
REMONUMENTATION**

APR 28 1995

COMMISSION

**LAND CORNER RECORDATION CERTIFICATE
Filing Requirement of Act 74, Mich. P.A. 1970**

For corners in

Manistee
(County)

Located In:

Corner Code ##

- | | | | | | |
|------------------------------------|---|------------|---|-------------|-------------|
| 1. Public Land Survey | T | <u>23N</u> | R | <u>13 W</u> | <u>B-11</u> |
| | T | _____ | R | _____ | _____ |
| | T | _____ | R | _____ | _____ |
| | T | _____ | R | _____ | _____ |
| 2. Property Controlling in Section | S | _____ | T | _____ | _____ |
| | S | _____ | T | _____ | _____ |
| 3. Miscellaneous Property in Sec. | S | _____ | T | _____ | _____ |
| | S | _____ | T | _____ | _____ |

REGISTER'S OFFICE
MANISTEE COUNTY

94-539 AT 10:45 A.M.

NOV 29 1994

Penny A. Pepera
REGISTER OF DEEDS

Register of Deeds Stamp & File Number

4. Lot No. _____, Recorded Plat _____
5. Private Claims _____

I, Bruce J. Jenema, in a field survey on Sept. 1, 19 94, do hereby certify that under requirements of P.A. 74, Michigan P.A. of 1970, the corner points mentioned in lines 1 and 2 above were in conformance with regulations and rules therefore as required in the current manual of survey instructions of the United States Department of the Interior, Bureau of Land Management or by a decree of a Court of Law and/or that the corner points mentioned in lines 3, 4 and 5 above were in conformance with the rules of the Michigan Board of Land Surveyors or by a Decree of a Court of Law; established, re-established, monumented, re-monumented, recovered, found as expressed below:

A	B	C	D	E	F	G	H	I	J	K	L	M
2	6	5	4	3	2	1						
3												
4	7	8	9	10	11	12						
5												
6	18	17	16	15	14	13						
7												
8	19	20	21	22	23	24						
9												
10	30	29	28	27	26	25						
11												
12	31	32	33	34	35	36						
13												


NOTE: Not more than 4 corners, all in the same town and range, may be recorded on this certificate.

A. Description of original monument and accessories and/or subsequent restoration:

B-11 Corner common to Sections 30 & 31, T23N, R13W
1839 John Brink G.L.O. Surveyor Set Post & Witness By:
8" Birch N56°E 20 links 7" Birch S29°E 7 links
5-11-1909 E.H. Baird Witnessed WPS 18" N39°E 49 links "Found old bearing tree" and WPS 20" N73°E 33 links page 286, Book "B" Manistee County Records.

B. Description of corner evidence found and/or method applied in restoring or reestablishing corner:

B-11 On 9-1-1994 Found witness WPS 20" N73°E 33 links [27.78'] to re-establish this corner

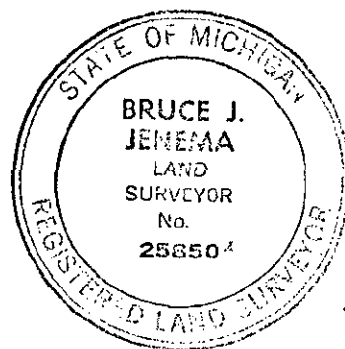

C. Description of monument for corner and accessories established to perpetuate locating the position of the corner:

As a careful and faithful re-establishment of this corner I have set a 2" x 30" steel pipe with a brass I.D. cap and Witnessed by:
10" Maple S45°E 38.12 ft.
12" Maple S30°E 45.55 ft.
8" Oak S90°W 36.10 ft.
12" Poplar S55°W 8.80 ft.

Corner B-11 ratified by the Manistee County Peer Group according to the county plan adopted pursuant to P.A. 345 of 1990, as amended, (being the State Survey and Remonument Act, MCL 54.261 et. seq.). Date of Peer Review: October 7, 1994

APPROVED NOV 07 1994

Signed by Bruce J. Jenema Date November 3, 1994
Surveyor's Michigan License No. 25850