

**SURVEY & REMONUMENTATION**

**SURVEY & REMONUMENTATION**

**JAN 21 1998**

**APR 28 1998**

**LAND CORNER RECORDATION CERTIFICATE**  
**Filing Requirement of Act 74, Mich. P.A. 1970**

**SECTION**

For corners in Manistee  
 (County)

**SECTION**

Located In:

Corner Code #

**REGISTER'S OFFICE**  
**MANISTEE COUNTY**

#97261 AT 11:23a.m.  
**JUL 25 1997**

*Perry A. Rosen*  
**REGISTER OF DEEDS**

1. Public Land Survey	T	23N	R. 13W	M-7
	T		R	
	T		R	
	T		R	
2. Property Controlling in Section	S		T	R
	S		T	R
3. Miscellaneous Property in Section	S		T	R
	S		T	R

Register of Deeds Stamp & File Number

4. Lot No. \_\_\_\_\_, Recorded Plat \_\_\_\_\_  
 5. Private Claims \_\_\_\_\_

A	B	C	D	E	F	G	H	I	J	K	L	M
2	6	5	4	3	2	1						
3												
4	7	8	9	10	11	12						
5												
6	18	17	16	15	14	13						
7												
8	19	20	21	22	23	24						
9												
10	30	29	28	27	26	25						
11												
12	31	32	33	34	35	36						
13												

I, John C. Schulke, in a field survey on June 25th, 1997, do hereby certify that under requirements of P.A. 74, Michigan P.A. of 1970, the corner points mentioned in lines 1 and 2 above were in conformance with regulations and rules therefore as required in the current manual of survey instructions of the United States Department of the Interior, Bureau of Land Management or by a decree of a Court of Law and/or that the corner points mentioned in lines 3, 4 and 5 above were in conformance with the rules of the Michigan Board of Professional Surveyors or by a Decree of a Court of Law; established, re-established, monumented, re-monumented, recovered, found as expressed below:

**NOTE: Not more than 4 corners, all in the same town and range, may be recorded on this certificate.**


**A. Description of original monument and accessories and/or subsequent restoration:**

- M-7, Southeast Corner Section 13, T23N, R13E. 1975 J. Wilcox recorded LCRC, Liber 2, Page 746 Wexford Register of Deeds and set Wexford County Monument. References: Beech 16" S84°W 50 links (50.0 feet) (1), Beech 20" N09°W 30 links (19.8 feet) (2)
- 1909 Fargo Engineering "found stake and one witness probably U.S." 1978 C. Roser recorded LCRC, Liber 3, Page 204 Wexford County Register of Deeds. References: Sugar Maple 14" S31.5°W 45.5 links (30.0 feet) (3), Hemlock 20" N56.5°W 35.25 links (23.3 feet) (4)
- 1963 E. M. Combs found 1 1/4" iron pipe. References: Maple 12" S85°E 25.00 feet (5), Twin Maple 10" S85°W 12.90 feet (6), Twin Maple 10" South 17.00 feet (7)
- Set cedar post with location tag.

**B. Description of corner evidence found and/or method applied in restoring or reestablishing corner:**

M-7, Southeast Corner Section 13, T23N, R13E  
 Found Wexford County Monument in place as set by J. Wilcox. Found BT # 6, 8 & 9. The reason for slightly over a foot of difference between mine and early measurements is that I measured from the East trunk the other three were apparently measured from the West trunk of BT # 6. Concluded Combs, Wilcox and Roser all used the same corner location. BT 1, 2, 3, 4 & 7 are gone.

Corner M-07 ratified by the Manistee County Peer Group according to the county plan and the report to P.A. 345 of 1990, as amended, (being the State of Michigan Monument Act, MCL 54.261 et. seq.). Date of Peer Review: \_\_\_\_\_

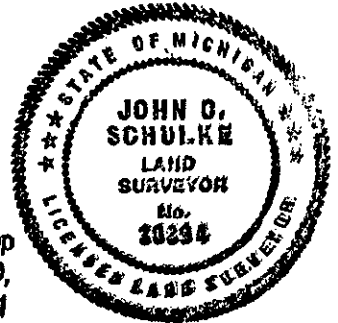

**C. Description of monument for corner and accessories established to perpetuate locating the position of the corner:**

M-7, Southeast Corner Section 13, T23N, R13E  
 Accept the Wexford County Monument as a careful and faithful perpetuation of the position of the original corner.  
 Corner References: Sugar Maple 13" S42°W 3.31 feet (8), Twin Sugar Maple 15" S81°W 11.73 feet (6), Red Maple 12" S08°W 16.95 feet (9), Red Oak 12" N10°W 35.07 feet (10) New BT

Signed by John C. Schulke  
 Surveyor's Michigan License No. 30894

Date July 10th, 1997