

LAND CORNER RECORDATION CERTIFICATE
FILING REQUIREMENT OF ACT 74, MICH. P.A.1970

FOR CORNERS OF-- LOCATED IN-- CORNER CODE NUMBER
1. PUBLIC LAND SURVEY... T. 23 N. R. 14 W. I-1; J-1; J-3; J-5
2. PROPERTY CONTROLLING IN SECTION... T. N. S. R. E. W.
3. MISCELLANEOUS PROPERTY IN SECTION... T. N. S. R. E. W.
4. LOT NO. RECORDED PLAT
5. PRIVATE CLAIMS

REGISTER OF DEEDS STAMP AND FILING NUMBER

I, Carl F. Roser do hereby certify that under requirements of P.A. 74, Michigan P.A. of 1970, the corner points mentioned in lines 1 and 2 above (identified with circles on index code diagram - over) were, in a field survey on 1-9 1973, established, re-established, monumented, re-monumented, recovered or restored as expressed below and in conformance with regulations and rules therefore as required in the current manual of survey instructions of the United States Department of the Interior, Bureau of Land Management or by a decree of a court of law.

A. Description of original monument and accessories and/or subsequent restoration:

C. Continued:

Table with 2 columns: J-3 and J-5. J-3 items include 'Fd 3/4" "T" iron P.Pole N40E 49.78'', 'Cor. fn post N58W 41.74'', etc. J-5 items include 'Drove 1"x18" pipe from old Witness P.Pole S86E 31.06'', '4" R. Pine S34E 78.35'', etc.

B. Description of corner evidence found and/or method applied in restoring or re-establishing corner:

- I-1 Rewitnessed previous Department corner of record.
J-1 Restored corner on line between the NE cor S-2 (23-14) & SW corner S-35 (24-14) and on line between the S 1/2 Cro. & possible Ctr. (Fd.Ir) of Sec. 2 which fits very closely to a computed position by single proportion E&W.
J-3 Recovered old corner of record. See Co. Sur. Book, Pg 193, J.H. Millard 1914.
J-5 Restored corner from old Cor. Wit of Rec. See Co. Sur. Book Pg 193, at Reg of Deeds. J.H. Millard about 1914. Corner is in line with fence to East.

C. Description of monument for corner and accessories established to perpetuate locating the position of the corner:

Table with 2 columns: I-1 and J-1. I-1 items include 'Fd DNR Mon. Added Cedar Gd post', '7" Cedar S88W 25.7' Old KJO wit', etc. J-1 items include 'Drove B.SpK in frozen Rd.', '8" Maple S45E 44.0'', etc.


SIGNED BY Carl F. Roser DATE 6-15-73

SURVEYOR'S MICHIGAN REGISTRATION NO. 12028

FOR STATE AND UNITED STATES AGENCIES:

SIGNED BY CHIEF OF SURVEY PARTY DATE

APPROVED AND SIGNED BY MICHIGAN REGISTERED LAND SURVEYOR

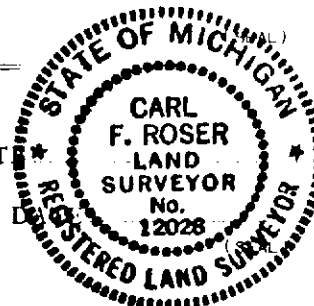

SURVEYOR'S MICHIGAN REGISTRATION NO.