

LAND CORNER RECONSTRUCTION CERTIFICATE
Filing Requirement of Act 74, Mich. P.A. 1970

For corners in

MANISTEE

(County)

Located In:

Corner Code #

H-13 per Hunt

REGISTER'S OFFICE
 MANISTEE COUNTY

03-569 AT 4:00 p.m.
OCT 5 1993

Limmy A. Popen
 REGISTER OF DEEDS

Register of Deeds Stamp & File Number

1. Public Land Survey

T 22N R 14W ~~SEC. 3, H-2~~
 T 23N R 14W H-13 ✓

2. Property Controlling in Section

S _____ T _____ R _____
 S _____ T _____ R _____

3. Miscellaneous Property in Sec.

S _____ T _____ R _____
 S _____ T _____ R _____

4. Lot No. _____, Recorded Plat _____

5. Private Claims _____

	A	B	C	D	E	F	G	H	I	J	K	L	M
2													
3													
I, Norman C. Caldwell, in a field survey on October, 1991,

do hereby certify that under requirements of P.A. 74, Michigan P.A. of 1970, the corner points mentioned in lines 1 and 2 above were in conformance with regulations and rules therefore as required in the current manual of survey instructions of the United States Department of the Interior, Bureau of Land Management or by a decree of a Court of Law and/or that the corner points mentioned in lines 3, 4 and 5 above were in conformance with the rules of the Michigan Board of Land Surveyors or by a Decree of a Court of Law; established, re-established, monumented, re-monumented, recovered, found as expressed below:

NOTE: Not more than 4 corners, all in the same town and range, may be recorded on this certificate.

A. Description of original monument and accessories and/or subsequent restoration:


H-1 1/4 cor., Sec. 3, 22/14W & 34, 23/14W
 Post placed by John Brink in 1839 Township line survey.
 N46°E 56 lks. (36.96') 13" Beech
 N44°W 58 lks. (36.28') 11" Hemlock

H-2 C 1/4, Sec. 3
 This position not established by original government survey.

B. Description of corner evidence found and/or method applied in restoring or reestablishing corner:

H-1 1/4 cor., Sec. 3, 22/14W & 34, 23/14W
 Found 1" iron pipe alongside large rock by A. Slawinski, #13597.
 N40°E 41.03' 12" Red Oak
 N80°E 51.97' 16" Twin Beech
 S10°W 40.54' 30" Maple

H-2 C 1/4, Sec. 3
 No Prior Record

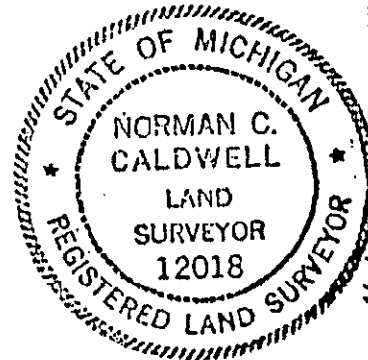

Corner H-1-1 ratified by the Manistee County Peer Group pursuant to P.A. 123 of 1915, as amended by P.A. 345 of 1990, as amended. Date of Peer Review: APR 25, 1993 (H-13, MAPLE GROVE)

C. Description of monument for corner and accessories established to perpetuate locating the position of the corner:

H-2 C 1/4, Sec. 3, T22N-R14W
 Placed 5" x 36" conc. monument w/brass cap #16923, 1991. This position not established by original government survey. This monument is accepted as a careful and faithful determination of the position of the corner.
 N74°W 3.97' 9" Beech
 N89°E 20.25' 4" Maple S.
 S01°W 22.69' 6" Maple S.
 North 1.0' Carsonite Witness Post

H-1 1/4 cor., Sec. 3, R22N-R14W & Sec. 34, T23N-R14W
 Found 1" pipe near large stone and replaced with 5" x 30" conc. monument and is accepted as the best available evidence of the position of the original corner.
 N40°E 41.03' 14" Onk B.
 N80°E 51.97' 18" Twin Beech
 S10°W 40.54' 30" Maple
 N70°W 23.07' 8" Poplar
 West 150'± CL gravel road to West
 South 20'± CL 2 track E-W
 North 180'± CL gravel road to North
 Carsonite Witness Post alongside

Signed by *Norman C. Caldwell*
 Surveyor's Michigan License No. 12018

Date 7 JAN. 1992

FORM APPROVED BY MICHIGAN STATE BOARD OF LAND SURVEYORS, JAN. 28, 1971
 REVISED MAY 14, 1975
 REVISED JAN., 1983

23 AUG. 1993