

**LAND CORNER RECORDATION CERTIFICATE**  
**Filing Requirement of Act 74, Mich. P.A. 1970**

For corners in

MANISTEE  
 \_\_\_\_\_  
 (County)

Located In:

Corner Code #

1. Public Land Survey

T 24N R 16W M-13

T 23N R 16W M-1

T 24N R 15W A-13

T 23N R 15W **(A-1) ✓**

2. Property Controlling in Section

S \_\_\_\_\_ T \_\_\_\_\_ R \_\_\_\_\_  
 S \_\_\_\_\_ T \_\_\_\_\_ R \_\_\_\_\_

3. Miscellaneous Property in Sec.

S \_\_\_\_\_ T \_\_\_\_\_ R \_\_\_\_\_  
 S \_\_\_\_\_ T \_\_\_\_\_ R \_\_\_\_\_

REGISTER'S OFFICE  
 MANISTEE COUNTY

#93-582 AT 11:40 A.M.

OCT 6 1993

*Penny A. Pepera*  
 REGISTER OF DEEDS

Register of Deeds Stamp & File Number

4. Lot No. \_\_\_\_\_, Recorded Plat \_\_\_\_\_  
 5. Private Claims \_\_\_\_\_

	A	B	C	D	E	F	G	H	I	J	K	L	M
2	6	5	4	3	2	1							
3													
4	7	8	9	10	11	12							
5													
6	18	17	16	15	14	13							
7													
8	19	20	21	22	23	24							
9													
10	30	29	28	27	26	25							
11													
12	31	32	33	34	35	36							
13													

I, Sammy S. Barnett, in a field survey on July, 1993, do hereby certify that under requirements of P.A. 74, Michigan P.A. of 1970, the corner points mentioned in lines 1 and 2 above were in conformance with regulations and rules therefore as required in the current manual of survey instructions of the United States Department of the Interior, Bureau of Land Management or by a decree of a Court of Law and/or that the corner points mentioned in lines 3, 4 and 5 above were in conformance with the rules of the Michigan Board of Land Surveyors or by a Decree of a Court of Law; established, re-established, monumented, re-monumented, recovered, found as expressed below:

**NOTE: Not more than 4 corners, all in the same town and range, may be recorded on this certificate.**

A. Description of original monument and accessories and/or subsequent restoration:

M-13 Section corner, Southeast Sec. 36

Post placed by John Brink in 1839 subdivision survey.

N 53.5° W 27 lks. (17.82') 12" Beech  
 S 40° W 51 lks. (33.66') 20" Sugar Maple

E. Whit found jar & stake in 1914.

B. Description of corner evidence found and/or method applied in restoring or reestablishing corner:

M-13 Section corner, Southeast Sec. 36

Found 1" square iron used by Anthony Slawinski in 1981 survey.

N 45° E 42.20' 20" Maple  
 N 45° W 52.23' 24" Maple  
 S 40° W 38.82' 36" Tw. Maple


Corner M-13 ratified by the Manistee County Peer Group pursuant to P.A. 123 of 1915, as amended by P.A. 345 of 1990, as amended. Date of Peer Review: **APPROVED AUG 2 1993**

C. Description of monument for corner and accessories established to perpetuate locating the position of the corner:

M-13 Section corner, Southeast Sec. 36

Found 1" square iron, replaced with Manistee County remon. monument, and is accepted as the best available evidence of the position of the original corner.

N 26° E 67.98' 16" Red Oak  
 S 32° E 135.50' 6" White Pine  
 S 40° W 74.28' 14" White Pine  
 N 45° W 52.26' 36" Sugar Maple

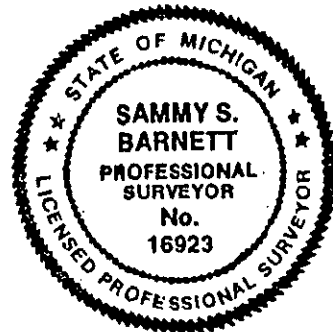

Signed by Sammy S. Barnett

Date 7/30/93

Surveyor's Michigan License No. 16923