MAY 1 6 1997

LAND CORNER RECORDATION CERTIFICATE

Filing Requirement of Act 74, Mich. P.A. 1970

For corners in Manistee (County)

	Located In:	Corner Code #
1. Public Land Survey	T 23N R 15W	A-07 SW Sec. 18
	T ___ R ___	CLOSING
	T ___ R ___	
	T ___ R ___	
2. Property Controlling	S ___ T ___ R ___	
in Section	S ___ T ___ R ___	
3. Miscellaneous	S ___ T ___ R ___	
Property in Sec.	S ___ T ___ R ___	

REGISTER'S OFFICE
MANISTEE COUNTY
96-4162 at 3:05pm
OCT 16 1996
Deborah Six
REGISTER OF DEEDS

Register of Deeds Stamp & File Number

4. Lot No. _____, Recorded Plat _____
5. Private Claims _____

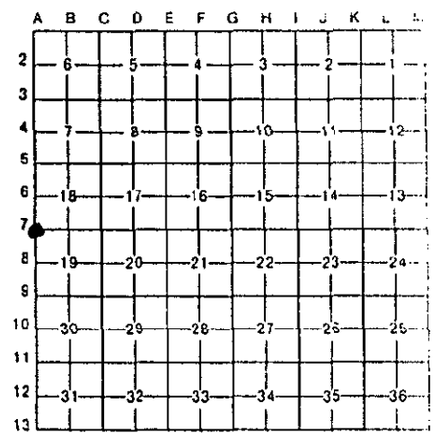

I, Bruce J. Jenema, in a field survey on September 9, 19 96, do hereby certify that under requirements of P.A. 74, Michigan P.A. of 1970, the corner points mentioned in lines 1 and 2 above were in conformance with regulations and rules therefore as required in the current manual of survey instructions of the United States Department of the Interior, Bureau of Land Management or by a decree of a Court of Law and/or that the corner points mentioned in lines 3, 4 and 5 above were in conformance with the rules of the Michigan Board of Land Surveyors or by a Decree of a Court of Law; established, re-established, monumented, re-monumented, recovered, found as expressed below:

NOTE: Not more than 4 corners, all in the same town and range, may be recorded on this certificate.

A. Description of original monument and accessories and/or subsequent restoration:

A-07 SW corner of Section 18, T23N, R15W
1839 Highbee Deputy Surveyor
(1) 20" Sugar S75°E 53 links (2) 18" Beech N64°E 74 links

1897 J.H. Millard Book A page 220 (3) 36" Elm N69°W 54 links
(4) 10" Maple N76°W 24 1/4 ft. (5) 15" Maple S50 1/2°W 45 1/4 links
Witnesses are now extinct.
1913 EWM Set stake & stones Used witnesses (4) & (5) Book A page 234

1961 MCRC Fnd. Iron Fence post 1.5' below surface & witnessed:
(5) 25" Maple ENE 67.73' (6) 30" Maple ESE 65.27' (7) 5" Cherry NE 81.52'

LCRC #73-19 K. Ross Cert. of survey L-3 Page 238 & LCRC, H. Bruning #7603
Found 1/2" Iron Rod (5) Maple 24" N77°E 67.73'
(5) 24" Oak NE 67.70' (6) Maple 30" S69°E 65.27'
(6) 32" Oak SE 64.24' (7) T. Pole S32°W 60.39'
(7) T.Pole SW 60.34' (8) T. Pole N24°W 75.80'

B. Description of corner evidence found and/or method applied in restoring or reestablishing corner:

On September 6,1996, I found a 5/8" iron bar.

C. Description of monument for corner and accessories established to perpetuate locating the position of the corner:

On September 9,1996, I installed a Manistee County Monument, within a monument box in the exact location of the above 5/8" iron rod and is accepted as a careful & faithful re-establishment of the position of the original corner and witnessed by:
(10) 36" Maple N75°E 39.68'
(11) P.Pole S52°E 52.05'
(12) 9" R.Pine S45°W 62.15'
(13) 40" Maple S13°E 137.25'
(14) South 18' Standard corner

Corner A-07 closing ratified by the Manistee County Peer Group according to the county plan adopted pursuant to P.A. 345 of 1990, as amended, (being the State Survey and Remonument Act, MCL 54.261 et seq.). Date of Peer Review: SEP 17 1996
Anthony M. Slaminski

Signed by Bruce J. Jenema Date September 9,1996
Surveyor's Michigan License No. 25850

STATE OF MICHIGAN BRUCE J. JENEMA LAND SURVEYOR NO 25850 PROFESSIONAL SURVEYOR

FORM APPROVED BY MICHIGAN STATE BOARD OF LAND SURVEYORS, JAN. 28, 1971
REVISED MAY 14, 1975
REVISED JAN., 1983