LAND CORNER RECORDATION CERTIFICATE
Filing Requirement of Act 74, Mich. P.A. 1970

For corners in
Manistee
(County)

	Located In:	Corner Code ##
1. Public Land Survey	T 23N R 15W	A-08 closing
	T ___ R ___	
	T ___ R ___	
	T ___ R ___	
2. Property Controlling	S ___ T ___ R ___	
in Section	S ___ T ___ R ___	
3. Miscellaneous	S ___ T ___ R ___	
Property in Sec.	S ___ T ___ R ___	

REGISTER'S OFFICE
MANISTEE COUNTY
#97-258 AT 11:17 A.M.
JUL 25 1997
Penny A. Pepere
REGISTER OF DEEDS

Register of Deeds Stamp & File Number

4. Lot No. _____, Recorded Plat _____
5. Private Claims _____

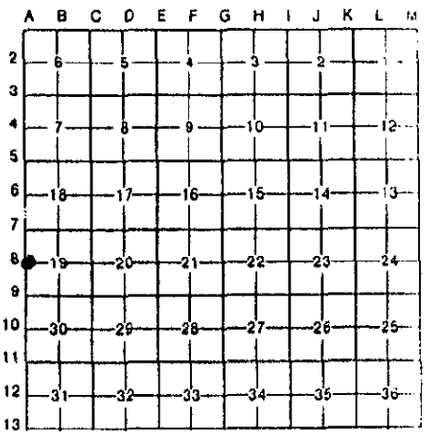

Bruce J. Jenema May 01 97
I, _____, in a field survey on _____, 19 _____, do hereby certify that under requirements of P.A. 74, Michigan P.A. of 1970, the corner points mentioned in lines 1 and 2 above were in conformance with regulations and rules therefore as required in the current manual of survey instructions of the United States Department of the Interior, Bureau of Land Management or by a decree of a Court of Law and/or that the corner points mentioned in lines 3, 4 and 5 above were in conformance with the rules of the Michigan Board of Land Surveyors or by a Decree of a Court of Law; established, re-established, monumented, re-monumented, recovered, found as expressed below:

NOTE: Not more than 4 corners, all in the same town and range, may be recorded on this certificate.

A. Description of original monument and accessories and/or subsequent restoration:

A-08 closing W ¼ Section 19, T23N, R15W
This corner was not established by the General Land Office.

SURVEY & REMONUMENTATION
OCT 14 1997
COMMISSION

B. Description of corner evidence found and/or method applied in restoring or reestablishing corner:

LCRC #73-19 Ken Ross found 1" iron pipe & witnessed:
(1) Pine SW 57.76' (2) Corner of house SE 154.56' (3) 10" Maple NE 122.16'
Standard corner for the East one-quarter corner of Section 25, T23N, R16W is South 19.00'
LCRC #74-8 Joe F. Berryman Found 1" iron pipe and witnessed:
(1) 10" Pine S75°W 57.72' (3) 36" Maple N15°E 121.80'

Corner A - 08 C ratified by the Manistee County Peer Group according to the county plan adopted pursuant to P.A. 345 of 1990, as amended, (being the State Survey and Remonument Act, MCL 54.261 et seq.). Date of Peer Review: Anthony M. Skawski
MAY 6 1997

STATE OF MICHIGAN
BRUCE J. JENEMA
LAND SURVEYOR NO. 25850
PROFESSIONAL LAND SURVEYOR

C. Description of monument for corner and accessories established to perpetuate locating the position of the corner:

On May 02,1997, I installed a Manistee County Monument, within a monument box in the exact location of the above 1" iron and this position not established by original government surveyors. This monument is accepted as the best available evidence of the postition of the corner and is witnessed by:

(7) 14" R.Pine N63°W 69.62'
Found witnesses 1 & 3 in good condition.

Signed by Bruce J. Jenema Date May 02,1997
Surveyor's Michigan License No. 25850

FORM APPROVED BY MICHIGAN STATE BOARD OF LAND SURVEYORS, JAN. 28, 1971
REVISED MAY 14, 1975
REVISED JAN., 1983