

**SURVEY &  
REMONUMENTATION**

OCT 31 1994

**COMMISSION LAND CORNER RECORDATION CERTIFICATE**  
Filing Requirement of Act 74, Mich. P.A. 1970

For corners in

<u>Manistee</u> (County)	Located In:	Corner Code =#
1. Public Land Survey	T <u>23N</u> R <u>15W</u>	<u>C-07</u>
	T _____ R _____	_____
	T _____ R _____	_____
	T _____ R _____	_____
2. Property Controlling in Section	S _____ T _____ R _____	_____
	S _____ T _____ R _____	_____
3. Miscellaneous Property in Sec.	S _____ T _____ R _____	_____
	S _____ T _____ R _____	_____

REGISTER'S OFFICE  
MANISTEE COUNTY

#94-317 AT 4:35 p.m.

JUL 11 1994

*Penny A. Pears*  
REGISTER OF DEEDS

Register of Deeds Stamp & File Number

4. Lot No. \_\_\_\_\_, Recorded Plat \_\_\_\_\_  
5. Private Claims \_\_\_\_\_

	A	B	C	D	E	F	G	H	I	J	K
2	6		5		4		3		2		
3											
4	7		8		9		10		11		
5											
6	18		17		16		15		14		
7											
8	19		20		21		22		23		
9											
10	30		29		28		27		26		
11											
12	31		32		33		34		35		
13											

I, Anthony M. Slawinski in a field survey on July 1, 1994, 19\_\_\_\_, do hereby certify that under requirements of P.A. 74, Michigan P.A. of 1970, the corner points mentioned in lines 1 and 2 above were in conformance with regulations and rules therefore as required in the current manual of survey instructions of the United States Department of the Interior, Bureau of Land Management or by a decree of a Court of Law and/or that the corner points mentioned in lines 3, 4 and 5 above were in conformance with the rules of the Michigan Board of Land Surveyors or by a Decree of a Court of Law; established, re-established, monumented, re-monumented, recovered, found as expressed below:

**NOTE: Not more than 4 corners, all in the same town and range, may be recorded on this certificate.**

A. Description of original monument and accessories and/or subsequent restoration:

C-07 SE cor sec 18 T23N R15W  
1839 James Higbee D.S. G.L.O. page 232  
Set post cor sec's 17-18-19 & 20  
#1 Sugar 24 N39°E 33 lks (21.78')  
#2 Hem 10 S 8W 32 lks (21.12')


B. Description of corner evidence found and/or method applied in restoring or reestablishing corner:

C-07 SE cor sec 18 T23N R15W  
On July 1, 1994 found 1/2" iron pipe, under pipe found 5/8" capped  
Re-rod 18" long.  
Condition of record witnesses are; #1 & #2 Gone

C. Description of monument for corner and accessories established to perpetuate locating the position of the corner:

C-07 SE cor sec 18 T23N R15W  
Replaced 1/2" iron pipe with a Manistee County Monument placed in a monument box, and is accepted as a careful and faithful reestablishment of the position of the original corner.  
S70°W 66.33' P.P.  
N36°W 71.50' SE cor of Barn  
S56°E 56.97' 8" Tri. Elm  
S36°W 79.03 20" maple

ratified by the Manistee County Peer Group according to the county plan adopted pursuant to P.A. 345 of 1990, as amended, (being the State Survey and Remonument Act, MCL 54.261 et seq.). Date of Peer Review: APPROVED JUL 11 1994

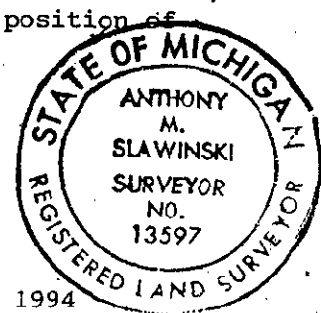

Signed by Anthony M. Slawinski Date July 1, 1994  
Surveyor's Michigan License No. 13597