

OCT 31 1994

COMMISSION

LAND CORNER RECORDATION CERTIFICATE
Filing Requirement of Act 74, Mich. P.A. 1970

For corners in

Manistee (County)	Located In:	Corner Code #
1. Public Land Survey	T 23N R 15W	E-05
	T _____ R _____	_____
	T _____ R _____	_____
	T _____ R _____	_____
2. Property Controlling in Section	S _____ T _____ R _____	_____
	S _____ T _____ R _____	_____
3. Miscellaneous Property in Sec.	S _____ T _____ R _____	_____
	S _____ T _____ R _____	_____


REGISTER'S OFFICE
MANISTEE COUNTY

#94-315 AT 3:27 p.m.
JUL 11 1994

Remy A. Pepera
REGISTER OF DEEDS

Register of Deeds Stamp & File Number

4. Lot No. _____ Recorded Plat _____
5. Private Claims _____

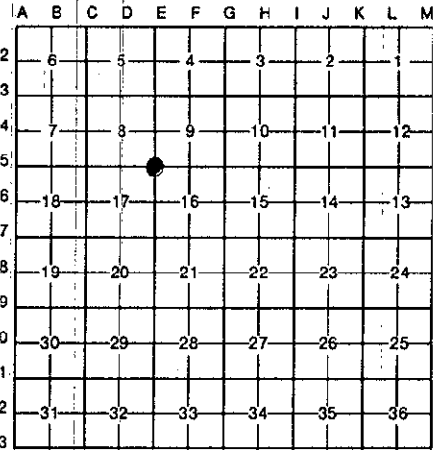

Anthony M. Slawinski in a field survey on July 1, 1994 do hereby certify that under requirements of P.A. 74, Michigan P.A. of 1970, the corner points mentioned in lines 1 and 2 above were in conformance with regulations and rules therefore as required in the current manual of survey instructions of the United States Department of the Interior, Bureau of Land Management or by a decree of a Court of Law and/or that the corner points mentioned in lines 3, 4 and 5 above were in conformance with the rules of the Michigan Board of Land Surveyors or by a Decree of a Court of Law; established, re-established, monumented, re-monumented, recovered, found, as expressed below:

NOTE: Not more than 4 corners, all in the same town and range, may be recorded on this certificate.

A. Description of original monument and accessories and/or subsequent restoration:

E-05 SE cor sec 8 T23N R15W
1839 James Higbee D.C. G.L.O. Page 228
Set post cor sec's 8-9-16 & 17
#1 Sugar 14 N53°E 20 lks (13.20')
#2 hem 20 S63°W 50 lks (33.00')

Manistee County Road Commission
1/2" iron Rod
#3 SSW 28.16' Tele Pole
#4 NW 51.53' 29" Maple
#5 NW 53.26' 34" Maple
#6 NE 40.89' Culvert Rivet head
#7 WNW 54.46' Tele. Pole

B. Description of corner evidence found and/or method applied in restoring or reestablishing corner:

E-05 SE cor sec 8 T23N R15W
On July 1, 1994 found Boat Spike, under Boat Spike found another Boat Spike.
Condition of record witnesses are: #1 thru #7 Gone

C. Description of monument for corner and accessories established to perpetuate locating the position of the corner:

E-05 SE cor Sec 8 T23N R15W
Replaced Boat Spike with a Manistee County Monument placed in a monument box and is accepted as a careful and faithful reestablishment of the position of the original corner.

S41°E 47.60' 6" Elm
S35°W 40.75' 6" Locust
N29°W 52.92' 30" Maple stump
N64°E 49.92' Power pole

Signed by *Anthony M. Slawinski*
Surveyor's Michigan License No. 13597

Date July 1, 1994



Corner E-05 ratified by the Manistee County Peer Group according to the county plan adopted pursuant to P.A. 345 of 1990, as amended, (being the State Survey and Remonument Act, MCL 54.261 et. seq.) - Date of Peer Review: *December 1994*