

LAND CORNER RECORDATION CERTIFICATE
Filing Requirement of Act 74, Mich. P.A. 1970

1993

For corners in

Table with columns: MANISTEE (County), Located In:, Corner Code #. Rows include Public Land Survey, Property Controlling in Section, Miscellaneous Property in Sec.

COMMISSION REGISTER'S OFFICE MANISTEE COUNTY #93-688 AT 4:33 p.m. DEC 21 1993 Penny A. Perna REGISTER OF DEEDS

Register of Deeds Stamp & File Number

4. Lot No. , Recorded Plat
5. Private Claims

Grid table with columns A-M and rows 2-13. A dot is marked at the intersection of column D and row 9.

I, Sammy S. Barnett, in a field survey on November 29, 1993, do hereby certify that under requirements of P.A. 74, Michigan P.A. of 1970, the corner points mentioned in lines 1 and 2 above were in conformance with regulations and rules therefore as required in the current manual of survey instructions of the United States Department of the Interior, Bureau of Land Management or by a decree of a Court of Law and/or that the corner points mentioned in lines 3, 4 and 5 above were in conformance with the rules of the Michigan Board of Land Surveyors or by a Decree of a Court of Law; established, re-established, monumented, re-monumented, recovered, found as expressed below:

NOTE: Not more than 4 corners, all in the same town and range, may be recorded on this certificate.


A. Description of original monument and accessories and/or subsequent restoration:

F-9 1/4 corner, Sec's. 21&28, T23N,R16W.

1839, John Brink D.S.,G.L.O. Placed Wood Stake

1978, Nordlund,Dunlap Set 1/2" re-rod 36" long No witnesses

- #1 14" Beech N08°W 65 lks.
#2 18" Beech S22°W 20 lks.

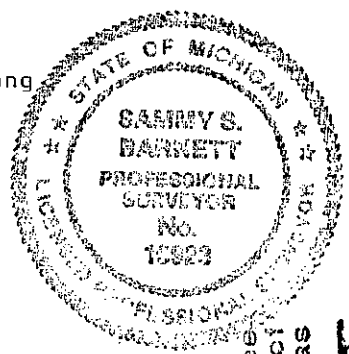

B. Description of corner evidence found and/or method applied in restoring or reestablishing corner:

F-9 1/4 corner, Sec's. 21&28, T23N,R16W.

Nordlund-Dunlap established the location of 1/4 corner by single proportional method, using exciting North 1/4 corner and Center 1/4 corner of Section 21, for the controlling corners. Found Nordlund-Dunlap 1/2" re-rod on November 16, and accepted as the corner due to lack of conflicting evidence. Condition of recorded witnessess. #1 Gone #2 Gone

Corner F-9 is used by the Manistee County Peer Group pursuant to P.A. 125 of 1915, as amended by P.A. 345 of 1990, as amended. Date of Peer Review APPROVED DEC 6 1993

C. Description of monument for corner and accessories established to perpetuate locating the position of the corner:

F-9 1/4 corner, Sec's. 21&28, T23N,R16W.

Replaced 1/2" x 36" re-rod with a Manistee County Monument(2 1/2"x30" steel pipe with brass cap), and is accepted as the best available evidence of the position of the original corner.

- 18" B. Ash S75°W 282.00' (60d spike in NW side of tree)
12" S. Maple N41°W 190.83' (60d spike in SW side of tree)
10" W. Cherry N23°E 178.23' (60d spike in NW side of tree)
5" Tw. Cedar S74°E 130.97' (60d spike in NE side of tree)

Signed by Sammy S. Barnett Date 12/31/93

Surveyor's Michigan License No. 16923