

SURVEY & REMONUMENTATION

OCT 31 1994

COMMISSION LAND CORNER RECORDATION CERTIFICATE
 Filing Requirement of Act 74, Mich. P.A. 1970

For corners in

<u>Manistee</u> <small>(County)</small>	Located In:	Corner Code #
1. Public Land Survey	T <u>23N</u> R <u>16W</u>	<u>G-8</u>
	T _____ R _____	_____
	T _____ R _____	_____
	T _____ R _____	_____
2. Property Controlling in Section	S _____ T _____ R _____	_____
	S _____ T _____ R _____	_____
3. Miscellaneous Property in Sec.	S _____ T _____ R _____	_____
	S _____ T _____ R _____	_____

REGISTER'S OFFICE
 MANISTEE COUNTY
 #94-441 AT 10:20 A.M.
SEP 29 1994
Penny A. Paras
 REGISTER OF DEEDS

Register of Deeds Stamp & File Number

4. Lot No _____, Recorded Plat _____
 5. Private Claims _____


A	B	C	D	E	F	G	H	I	J	K	L	M
2	6	5	4	3	2	1						
3												
4	7	8	9	10	11	12						
5												
6	18	17	16	15	14	13						
7												
8	19	20	21	22	23	24						
9												
10	30	29	28	27	26	25						
11												
12	31	32	33	34	35	36						
13												

Bruce J. Jenema, in a field survey on September 7, 1994, do hereby certify that under requirements of P.A. 74, Michigan P.A. of 1970, the corner points mentioned in lines 1 and 2 above were in conformance with regulations and rules therefore as required in the current manual of survey instructions of the United States Department of the Interior, Bureau of Land Management or by a decree of a Court of Law and/or that the corner points mentioned in lines 3, 4 and 5 above were in conformance with the rules of the Michigan Board of Land Surveyors or by a Decree of a Court of Law, established, re-established, monumented, re-monumented, recovered, found as expressed below:

NOTE: Not more than 4 corners, all in the same town and range, may be recorded on this certificate.

A. Description of original monument and accessories and/or subsequent restoration:
 G-8 1839 James Highbee Set 1/4 Sec. post
 Beech 8" S23°W 5 links Hemlock N67°W 17 links
 No county Surveyor records found
 Plat of Portgage Park Addition shows concrete monument

B. Description of corner evidence found and/or method applied in restoring or reestablishing corner:
 Found a 5"x5" square concrete monument with an "x" formed on the top in solid condition

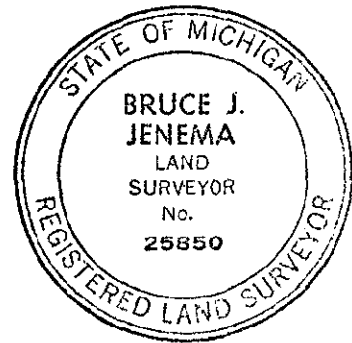

C. Description of monument for corner and accessories established to perpetuate locating the position of the corner:
 Left the existing 5"x5" concrete monument in place as a monument for this corner, and is accepted as a careful & faithful re-establishment and witness by:
 N78°E 10" Hemlock 13.08' S17°E 10" Hemlock 8.18'
 N20°W Triple 30" Maple 16.91' S56°W 12" Hemlock 8.53'

Corner G-08 ratified by the Manistee County Peer Group according to the county plan adopted pursuant to P.A. 345 of 1990, as amended, (being the State Survey and Remonument Act, MCL 54.261 et seq.). Date of Peer Review: Anthony M. Stankovic
APPROVED SEP 12 1994

Signed by Bruce J. Jenema Date 9-8-94
 Surveyor's Michigan License No. 25850