

LAND CORNER RECORDATION CERTIFICATE
Filing Requirement of Act 74, Mich. P.A. 1970

1993

For corners in
MANISTEE
(County)

Located In: Corner Code #

REGISTER'S OFFICE
MANISTEE COUNTY
93-687 AT 4:30 p.m.
DEC 21 1993
Penny A. Pepona
REGISTER OF DEEDS

- 1. Public Land Survey T 23N R 16W G-9
T _____ R _____
T _____ R _____
T _____ R _____
- 2. Property Controlling S _____ T _____ R _____
in Section S _____ T _____ R _____
- 3. Miscellaneous S _____ T _____ R _____
Property in Sec. S _____ T _____ R _____

Register of Deeds Stamp & File Number

- 4. Lot No. _____, Recorded Plat _____
- 5. Private Claims _____

	A	B	C	D	E	F	G	H	I	J	K	L	M
2	6	5	4	3	2	1							
3													
4	7	8	9	10	11	12							
5													
6	18	17	16	15	14	13							
7													
8	19	20	21	22	23	24							
9													
10	30	29	28	27	26	25							
11													
12	31	32	33	34	35	36							
13													

I, Sammy S. Barnett, in a field survey on November 29, 1993, do hereby certify that under requirements of P.A. 74, Michigan P.A. of 1970, the corner points mentioned in lines 1 and 2 above were in conformance with regulations and rules therefore as required in the current manual of survey instructions of the United States Department of the Interior, Bureau of Land Management or by a decree of a Court of Law and/or that the corner points mentioned in lines 3, 4 and 5 above were in conformance with the rules of the Michigan Board of Land Surveyors or by a Decree of a Court of Law; established, re-established, monumented, re-monumented, recovered, found as expressed below:

NOTE: Not more than 4 corners, all in the same town and range, may be recorded on this certificate.

A. Description of original monument and accessories and/or subsequent restoration:

G-9 Section corner, Sec's. 21,22,27&28, T23N,R16W.

1839, John Brink D.S., G.L.O.
Placed Wood Stake

1916, C.E. Mitchell


- #1 8" Beech S21°E 53 lks.
- #2 24" Hemlock S58°W 31 lks.
- #3 24" Birch S62°E 148 lks.
- #4 8" Birch S22½°E 136 lks.

B. Description of corner evidence found and/or method applied in restoring or reestablishing corner:

G-9 Section corner, Sec's. 21,22,27&28, T23N,R16W.

On November 16, found a 4" sq. by 25" old concrete monument with a "X" chiseled on the top of monument. Also found three witness trees by person unknow. Accepted concrete monument for the location of the corner. Condition of witnesses, #1 Gone #2 Gone #3 Gone #4 Gone

Corner 6-9 ratified by the Manistee County Peer Group pursuant to P.A. 123 of 1915, as amended by P.A. 345 of 1990, as amended. Date of Peer Review: 6-1993
APPROVED DEC 6 1993

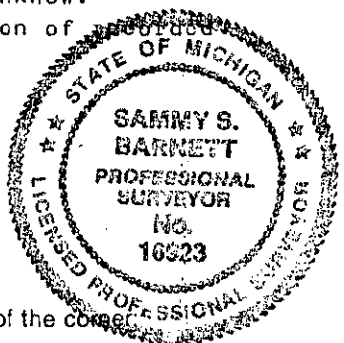

C. Description of monument for corner and accessories established to perpetuate locating the position of the corner:

G-9 Section corner, Sec's. 21,22,27&28, T23N,R16W.

Replaced 4" x 25" concrete monument with a Manistee County Monument (2½"x30" steel pipe with brass cap), and is accepted as the best available evidence of the position of the original corner.

- (OBT) 11" W. Pine S50°E 3.02' (60d spike in SW side of tree)
- (OBT) 8" W. Pine N07°E 11.20' (60d spike in NW side of tree)
- (OBT) 9" W. Pine N37°W 11.95' (60d spike in SW side of tree)
- Power Pole S74°W 159.45' (60d spike in NW side of pole)

Signed by Sammy S. Barnett Date 12/31/93
Surveyor's Michigan License No. 16923