

SURVEYOR  
REMO

OCT 31 1994

COMMISSION

LAND CORNER RECORDATION CERTIFICATE  
Filing Requirement of Act 74, Mich. P.A. 1970

For corners in  
Manistee

(County)

Located In:

Corner Code #

1. Public Land Survey	T <u>23N</u> R <u>16W</u>	I-7
	T _____ R _____	_____
	T _____ R _____	_____
	T _____ R _____	_____
2. Property Controlling in Section	S _____ T _____ R _____	_____
	S _____ T _____ R _____	_____
3. Miscellaneous Property in Sec.	S _____ T _____ R _____	_____
	S _____ T _____ R _____	_____

REGISTER'S OFFICE  
MANISTEE COUNTY

#94-450 AT 10:55 A.M.

SEP 29 1994

*Penny A. Proctor*  
REGISTER OF DEEDS

Register of Deeds Stamp & File Number

4. Lot No. \_\_\_\_\_, Recorded Plat \_\_\_\_\_  
5. Private Claims \_\_\_\_\_

A	B	C	D	E	F	G	H	I	J	K	L	M
2	6	5	4	3	2	1						
3												
4	7	8	9	10	11	12						
5												
6	13	17	16	15	14	13						
7												
8	19	20	21	22	23	24						
9												
10	30	29	28	27	26	25						
11												
12	31	32	33	34	35	36						
13												

I, Bruce J. Jenema, in a field survey on August 15, 1994, do hereby certify that under requirements of P.A. 74, Michigan P.A. of 1970, the corner points mentioned in lines 1 and 2 above were in conformance with regulations and rules therefore as required in the current manual of survey instructions of the United States Department of the Interior, Bureau of Land Management or by a decree of a Court of Law and/or that the corner points mentioned in lines 3, 4 and 5 above were in conformance with the rules of the Michigan Board of Land Surveyors or by a Decree of a Court of Law; established, re-established, monumented, re-monumented, recovered, found as expressed below:


NOTE: Not more than 4 corners, all in the same town and range, may be recorded on this certificate.

A. Description of original monument and accessories and/or subsequent restoration:

Section corner common to 14,15,22 & 23 T23N R16W  
I-7 James Highbee GLO Surveyor post between Sections 14,15,22 & 23  
Birch 12" N66°E 19 links 14" Aspen S44°W 12 links  
1908 E.W. Manchester "No US Witness", establish at 40 chains from N 1/4 Section 23,  
Witness Oak 4" N9°12"E 18 links, Beech 7" N78°W 48 links  
Book A, page 236, Book B, page 330

B. Description of corner evidence found and/or method applied in restoring or reestablishing corner:

On 8-15-94 Found Axel Shaft  
M.D.O.T. 487.71 East to center line highway M-22 and 2607.18 ft. to the N 1/4 corner  
Section 23, T23N, R16W

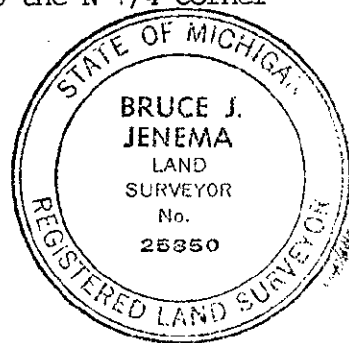

C. Description of monument for corner and accessories established to perpetuate locating the position of the corner:

Replaced axel shaft with Manistee County Monument (2 1/2" x 30" steel pipe with brass cap) and is accepted as a careful and faithfull re-establishment of the position of the original corner and witness by  
14" Oak S53°E 8.58' Found 11" Oak S42°W 16.94'  
10" Oak S45°E 6.35' Found  
20" Oak S89°W 13.41' Found

Corner I-07 ratified by the Manistee County Peer Group according to the county plan adopted pursuant to P.A. 345 of 1990, as amended, (being the State Survey and Remonument Act, MCL 54.261 et. seq.) . Date of Peer Review: Anthony M. Stamm  
APPROVED SEP 12 1994

Signed by Bruce J. Jenema  
Surveyor's Michigan License No. 25850

Date 9-8-94