

SURVEY & REMONUMENTATION

OCT 3 1 1994

LAND CORNER RECORDATION CERTIFICATE

COMMISSION Filing Requirement of Act 74, Mich. P.A. 1970

For corners in
MANISTEE
(County)

Located In: Corner Code #

- | | | |
|------------------------------------|---------------------------|------------|
| 1. Public Land Survey | T <u>23N</u> R <u>16W</u> | <u>K-5</u> |
| | T _____ R _____ | _____ |
| | T _____ R _____ | _____ |
| | T _____ R _____ | _____ |
| 2. Property Controlling in Section | S _____ T _____ R _____ | _____ |
| | S _____ T _____ R _____ | _____ |
| 3. Miscellaneous Property in Sec. | S _____ T _____ R _____ | _____ |
| | S _____ T _____ R _____ | _____ |

REGISTER'S OFFICE
MANISTEE COUNTY
94-448 AT 10:45A
SEP 2 9 1994
Penney A. Peave
REGISTER OF DEEDS

Register of Deeds Stamp & File Number

4. Lot No. _____, Recorded Plat _____
5. Private Claims _____

A	B	C	D	E	F	G	H	I	J	K	L	M
2	6	5	4	3	2	1						
3												
4	7	8	9	10	11	12						
5												
6	18	17	16	15	14	13						
7												
8	19	20	21	22	23	24						
9												
10	30	29	28	27	26	25						
11												
12	31	32	33	34	35	36						
13												

BRUCE J. JENEMA AUGUST 15, 1994

I, _____, in a field survey on _____, 19____, do hereby certify that under requirements of P.A. 74, Michigan P.A. of 1970, the corner points mentioned in lines 1 and 2 above were in conformance with regulations and rules therefore as required in the current manual of survey instructions of the United States Department of the Interior, Bureau of Land Management or by a decree of a Court of Law and/or that the corner points mentioned in lines 3, 4 and 5 above were in conformance with the rules of the Michigan Board of Land Surveyors or by a Decree of a Court of Law; established, re-established, monumented, re-monumented, recovered, found as expressed below:


NOTE: Not more than 4 corners, all in the same town and range, may be recorded on this certificate.

A. Description of original monument and accessories and/or subsequent restoration:

Section corner common to Sections 11,12,13 & 14, T23N, R16W
K-5 1839 James Highbee GLO Surveyor post between Sections 11,12,13 & 14
Beech 10" N31°E 20 links Beech 12" S49°E 32 links
1893 E.W. Manchester Found Stone No Witness given Book A page 234

B. Description of corner evidence found and/or method applied in restoring or reestablishing corner:

On August 15, 1994 Found 1/2" Iron rered :

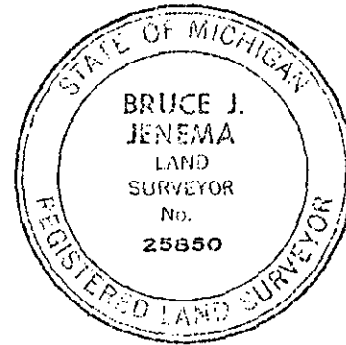

C. Description of monument for corner and accessories established to perpetuate locating the position of the corner:

Replaced 1/2" Iron rered with a Manistee County Monument (2 1/2"x30" steel pipe with a brass cap) placed in a monument box, and accepted as a careful and faithful re-establishment of the position of the original corner and witness by:

12" R. Pine S22°E 81.07 ft. Utility pole N55°E 29.12 ft.
9" B. Locust S29°W 55.00 ft. Twin 24" Oak N35°E 55.82 ft.

Corner K-05 ratified by the Manistee County Peer Group according to the county plan adopted pursuant to P.A. 345 of 1990, as amended, (being the State Survey and Remonument Act, MCL 54.261 et. seq.). Date of Peer Review: *Anthony M. Slavinski*

Signed by *Bruce J. Jenema*

Date

APPROVED SEP 12 1994

Surveyor's Michigan License No. 25850