

OCT 31 1994

COMMISSIONER LAND CORNER RECORDATION CERTIFICATE
Filing Requirement of Act 74, Mich. P.A. 1970

For corners in

Manistee
(County)

Located In: Corner Code #

- 1. Public Land Survey T 23N R 16W K-6
- T _____ R _____
- T _____ R _____
- T _____ R _____
- 2. Property Controlling S _____ T _____ R _____
- in Section S _____ T _____ R _____
- 3. Miscellaneous S _____ T _____ R _____
- Property in Sec. S _____ T _____ R _____
- 4. Lot No. _____, Recorded Plat _____
- 5. Private Claims _____

REGISTER'S OFFICE
MANISTEE COUNTY

#94-442 AT 10:23 A.M.

SEP 29 1994

Penney A. P. ...
REGISTER OF DEEDS

Register of Deeds Stamp & File Number

I, Bruce J. Jenema, in a field survey on August 20, 1994, do hereby certify that under requirements of P.A. 74, Michigan P.A. of 1970, the corner points mentioned in lines 1 and 2 above were in conformance with regulations and rules therefore as required in the current manual of survey instructions of the United States Department of the Interior, Bureau of Land Management or by a decree of a Court of Law and/or that the corner points mentioned in lines 3, 4 and 5 above were in conformance with the rules of the Michigan Board of Land Surveyors or by a Decree of a Court of Law; established, re-established, monumented, re-monumented, recovered, found as expressed below:

	A	B	C	D	E	F	G	H	I	J	K	L	M
2	6		5		4		3		2		1		
3													
4	7		8		9		10		11		12		
5													
6	13		17		16		15		14		13		
7													
8	19		20		21		22		23		24		
9													
10	30		29		28		27		26		25		
11													
12	31		32		33		34		35		36		
13													

NOTE: Not more than 4 corners, all in the same town and range, may be recorded on this certificate.

A. Description of original monument and accessories and/or subsequent restoration:


One-quarter corner between Sections 13 and 14, T23N, R16W
K-9 1839 James Highbee GLO Surveyor one-quarter corner between 13 and 14
Beech S20°E 13 links Beech 10" N36°W 28 links
1893 EW Manchester Establish testimony Goodfrey
Witness by:
Maple 10" N 7 3/4°W 123 links Hemlock 50" 61 1/3 links Book A page 234

B. Description of corner evidence found and/or method applied in restoring or reestablishing corner:

K-6 Found 3/4" x 12" iron pipe at the surface of Erdman Road

Corner K-06 ratified by the Manistee County Peer Group according to the county plan adopted pursuant to P.A. 345 of 1990, as amended, (being the State Survey and Remonument Act, MCL 54.261 et. seq.). Date of Peer Review: Anthony M. ...

APPROVED SEP 12 1994

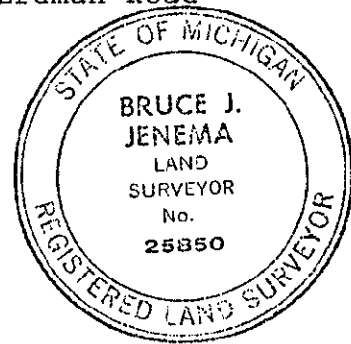

C. Description of monument for corner and accessories established to perpetuate locating the position of the corner:

K-6 Replaced 3/4" iron pipe with a Manistee County Monument (2 1/2" x 30" steel pipe with brass cap) placed in a monument box and is accepted as a careful and faithful re-established of the position of the original corner and witnessed by:
8" R. Pine N52°W 43.66' Utility pole S29°W 38.81'
Utility pole N46°W 49.61' 40" Maple S70°W 45.19'
36" Maple N68°E 72.08'

Signed by _____ Date Bruce J. Jenema
Surveyor's Michigan License No. 25850