RECEIVED
DEC 2 8 2003
STATION

LAND CORNER RECORDATION CERTIFICATE
Filing Requirement of Act 74, Mich. P.A. 1970

■ corners in

Manistee (County) — Located In: — Corner Code #

				Standard
Public Land Survey		T 23N	R 16W	M-03 SE cor. Sec. 1
		T___	R___	Standard
		T___	R___	
		T___	R___	
Property Controlling	S___	T___	R___	
in Section	S___	T___	R___	
Miscellaneous	S___	T___	R___	
Property in Sec.___	S___	T___	R___	

REGISTER'S OFFICE
MANISTEE COUNTY
98-373 at 10:30 am
SEP 17 1998
Deborah Lix
REGISTER OF DEEDS

Register of Deeds Stamp & File Number

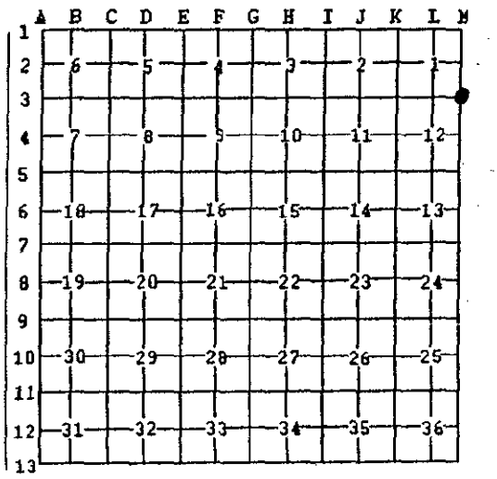

Lot No. _____, Recorded Plat _____
Private Claims _____

Bruce J. Jenema, in a field survey on August 1, 19 98 ■ hereby state that under requirements of P.A. 74, Michigan P.A. of 1970, the corner points mentioned lines 1 and 2 above were in conformance with regulations and rules therefore as required in the current anual of survey instructions of the United States Department of the Interior, Bureau of Land anagement or by a decree of a Court of Law and /or that the corner points mentioned in lines 3, 4 and 5 ove were in conformance with the rules of the Michigan Board of Land Surveyors or by a Decree of a ourt of Law; established, re-established, monumented, recovered, found as expressed below:

OTE: ***Not more than 2 corners, all in the same town and range, may be recorded on this certificate.***

A. *Description of original monument and accessories and/or subsequent restoration:*

1837 John Brink Set post for Sec. 1 & 12, from which a
(1) Beech 18" S17°W 13 links (2) Beech 11" N54°W 35 links
NOTE: Original Government Land Office map for T23N, R15W, does not indicate the existence of a closing corner, *however the original notes indicate a closing corner* 23.76' (36 links) North of this corner for the corner of Sec. 6 & 7, T23N, R15W.

B. Description of corner evidence found and/or method applied in restoring or reestablishing corner:

Dec. 7, 1914 E.W.M. found stone Book "A"
NOTE: This corner has not been used as a property control corner and is in conflict with occupation and the use of the SW corner of Sec. 6, T23N, R15W, as a property control corner.

C. Description of monument for corner and accessories established to perpetuate locating the position of the corner:

On August 1, 1998, I placed a standard Manistee County Monument as the position of this corner by measuring SOUTH 23.76' (36 links), the closing distance from original notes, from the NW cor. Sec. 7, T23N, R16W, along the West line of Sec. 7 as the best available evidence of the position of this corner and witnessed by:

(3) S65°E 75.90' 4" J. Pine 50-D N. side
(4) N25°E 131.51' 12" R. Pine 50-D S. side
(5) N40°W 93.65' 12" Maple 60-D N. side
(6) S08°E 157.20' U. Pole

Corner M – 0 3 STANDARD ratified by the Manistee County Peer Group according to the county plan adopted pursuant to P.A. 345 of 1990, as amended, (being the State Survey and Remonument Act, MCL 54.261 et. seq.). Date of Peer Review: Anthony M. Slawinski
AUG 4 1998

Signed by Bruce J. Jenema Date AUG 8 1998
Surveyor's Michigan License No. 25850

STATE OF MICHIGAN
BRUCE J. JENEMA
LAND SURVEYOR NO. 25850
PROFESSIONAL LAND SURVEYOR

FORM APPROVED BY MICHIGAN STATE BOARD OF PROFESSIONAL SURVEYORS, JAN. 28, 197
REVISED MAY 14,197
REVISED JAN., 1983
REVISED OCT., 1995