SURVEY & MONUMENTATION

MAY 1 6 1997

COMMISSION

LAND CORNER RECORDATION CERTIFICATE

Filing Requirement of Act 74, Mich. P.A. 1970

For corners in Manistee (County)

REGISTER'S OFFICE
MANISTEE COUNTY
96-464 at 3:15pm
OCT 1 6 1996
Deborah Lyk
REGISTER OF DEEDS

Register of Deeds Stamp & File Number

	Located In:	Corner Code ##
1. Public Land Survey	T 23N R 16W	M-08 E¼ Sec. 24 STANDARD CORNER
	T ___ R ___	
	T ___ R ___	
	T ___ R ___	
2. Property Controlling	S ___ T ___ R ___	
in Section	S ___ T ___ R ___	
3. Miscellaneous	S ___ T ___ R ___	
Property in Sec.	S ___ T ___ R ___	

4. Lot No. _____ , Recorded Plat _____
5. Private Claims _____

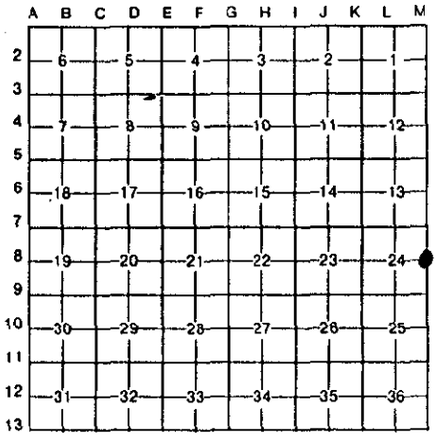

I, Bruce J. Jenema, in a field survey on September 9, 19 96, do hereby certify that under requirements of P.A. 74, Michigan P.A. of 1970, the corner points mentioned in lines 1 and 2 above were in conformance with regulations and rules therefore as required in the current manual of survey instructions of the United States Department of the Interior, Bureau of Land Management or by a decree of a Court of Law and/or that the corner points mentioned in lines 3, 4 and 5 above were in conformance with the rules of the Michigan Board of Land Surveyors or by a Decree of a Court of Law; established, re-established, monumented, re-monumented, recovered, found as expressed below:

NOTE: Not more than 4 corners, all in the same town and range, may be recorded on this certificate.

A. Description of original monument and accessories and/or subsequent restoration:

M-08 E 1/4 corner of Section 24, T23N, R16W,
1839 Brink Deputy Surveyor
(1) 12" Lynn N24°W 25 links (2) Hemlock S23°W 34 links
June 1913 EWM Gas Pipe by Testimony of E & B. Book A page 234
Witnesses now extinct.

B. Description of corner evidence found and/or method applied in restoring or reestablishing corner:

L.C.R.C. #73-19 found 1" IP for closing corner W 1/4 corner Section 19, T23N, R15W On 9-22-95 I made a survey in the NE 1/4 of Section 24, T23N, R16W, and I set a 1/2" iron for corner M-08 19' South of the W 1/4 corner & witnessed by:
(3) P.Pole S60°W 46.43' (4) 6" Ash N30°E 58.52'
(5) 8" R.Pine N35°W 77.17' (6) 12" Cherry S40°E 36.80'
(7) 1" I.Pipe N00°E 19.00'

Corner M - 08 E STANDARD Ratified by the Manistee County Peer Group according to the county plan adopted pursuant to P.A. 345 of 1[illegible], as amended, (being the State Survey and Remonument Act, M[illegible] et. seq.). Date of Peer Review: SEP 1 7 1996
Anthony M. Stamatis

C. Description of monument for corner and accessories established to perpetuate locating the position of the corner:

On September 9,1996, I installed a Manistee County Monument, within a monument box in the exact location of the above 1/2" iron rod and is accepted as a careful & faithful re-establishment of the position of the original corner and witnessed by: Witnesses (3), (4), (5), (6) & (7) were found in good condition.

STATE OF MICHIGAN
BRUCE J. JENEMA
No. 25850
MICHIGAN LAND SURVEYOR

Signed by Bruce J. Jenema Date September 9,1996

Surveyor's Michigan License No. 25850

FORM APPROVED BY MICHIGAN STATE BOARD OF LAND SURVEYORS, JAN. 28, 1971
REVISED MAY 14, 1975
REVISED JAN., 1983