

# LAND CORNER RECORDATION CERTIFICATE

FILING REQUIREMENT OF ACT 74, MICH. P.A.1970

FOR CORNERS OF--:	LOCATED IN--:	CORNER CODE NUMBER
1. PUBLIC LAND SURVEY	T. 24 N. R. 13 W.	L-5; M-4
2. PROPERTY CONTROLLING IN SECTION	T. S. R. E. W.	
3. MISCELLANEOUS PROPERTY IN SECTION	T. S. R. E. W.	
4. LOT NO. _____, RECORDED PLAT _____		
5. PRIVATE CLAIMS _____		

REGISTER OF DEEDS STAMP AND FILING NUMBER

I, Carl F. Roser, do hereby certify that under requirements of P.A. 74, Michigan P.A. of 1970, the corner points mentioned in lines 1 and 2 above were, in a field survey on June 23, 1976, 19\_\_\_\_, established, re-established, monumented, re-monumented, recovered or restored as expressed below and in conformance with regulations and rules therefore as required in the current manual of survey instructions of the United States Department of the Interior, Bureau of Land Management or by a decree of a court of law. Furthermore, that the corner points mentioned in lines 3, 4 and 5 above were, in a field survey on \_\_\_\_\_, 19\_\_\_\_, found, recovered, restored, established or re-established as expressed below and in conformance with the rules of the Michigan State Board of Registration for Land Surveyors or, by a Decree of a Court of law:

A. Description of original monument and accessories and/or subsequent restoration:

B. Description of corner evidence found and/or method applied in restoring or re-establishing corner:

- L-5 Found rod with RLS cap #18990, in E-W dirt county road, Center road N, Due E, 15', on line with old fence N & S.
- M-4 Restored 1/4 corner on Twp. (county) line, on line between found section corners 1/2 mile to N & S and on line across 1/4 line to W where we recovered the center of Sec. 12 and the E 1/16 & W 1/16 on E-W 1/4 line. The quarter corner restored by this procedure fits very definite swamp edge 264' N per U.S. tie and possible hemlock line tree (stump remains at 262' N). Any quarter corner position N or W of our position could not possibly fit U.S. tie to swamp edge.

C. Description of monument for corner and accessories established to perpetuate locating the position of the corner:

L-5	M-4
3/4" rod w/R.L.S. cap	Set std. Wexford Co. monument & cedar post w/loc. tag
*36" Maple N55°E 41.03	20" Maple N45°W 50.8
36" Maple N77°E 89.86	12" Maple S60°W 43.4
*16" Apple S33°E 105.50	12" Hemlock S08°W 43.9
*Power Pole Due S 117.65	13" Hemlock N48°E 13.2
Set cedar post w/loc. tag	Center old N-S Twp. Road Grade
Due N 33	Due E 39±
*(previously witnessed)	

SIGNED BY Carl F. Roser 4-28-77 DATE \_\_\_\_\_

SURVEYOR'S MICHIGAN REGISTRATION NO. 12028


FOR STATE AND UNITED STATES AGENCIES:

SIGNED BY \_\_\_\_\_ DATE \_\_\_\_\_

CHIEF OF SURVEY PARTY

APPROVED AND SIGNED BY \_\_\_\_\_ DATE \_\_\_\_\_

MICHIGAN REGISTERED LAND SURVEYOR

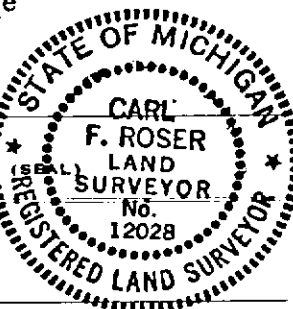

(SEAL)

SURVEYOR'S MICHIGAN REGISTRATION NO. \_\_\_\_\_

CLEON TOWNSHIP  
MANISTEE COUNTY