

MAY 03 2000

LAND CORNER RECORDATION CERTIFICATE

Filing Requirement of Act 74, Mich. P.A. 1970

SECTION

For corners in Manistee County (County)

Located In:

Corner Code #

REGISTER'S OFFICE MANISTEE COUNTY

00-001 AT 9:30 A.M.

JAN 03 2000

Penney A. Lopez REGISTER OF DEEDS

Register of Deeds Stamp & File Number

- 1. Public Land Survey T 24N R 13W K01
2. Property Controlling in Section S T R
3. Miscellaneous Property in Section S T R

- 4. Lot No. Recorded Plat
5. Private Claims

Grid table with columns A-L and rows 1-13. A dot is marked in column K, row 2.

I, John C. Schulke, in a field survey on May 27th, 1999, do hereby certify that under requirements of P.A. 74, Michigan P.A. of 1970, the corner points mentioned in lines 1 and 2 above were in conformance with regulations and rules therefore as required in the current manual of survey instructions of the United States Department of the Interior, Bureau of Land Management or by a decree of a Court of Law and/or that the corner points mentioned in lines 3, 4 and 5 above were in conformance with the rules of the Michigan Board of Professional Surveyors or by a Decree of a Court of Law; established, re-established, monumented, re-monumented, recovered, found as expressed below:


NOTE: Not more than 4 corners, all in the same town and range, may be recorded on this certificate.

A. Description of original monument and accessories and/or subsequent restoration:

- K-01 Closing Corner of Sections 1 and 2, T24N, R13W and Standard Corner of Sections 35 and 36 T25N, R13W.
1838 John Brink US Deputy Surveyor Set Post.
1839 John Brink at 85.17 ch intersected N Boundary at post.
1911 Manistee Co. Surveyor's Book A, Page 247, Plow Point, EWM, no references.
1973 L J Czubak, LS 12581 Found 1" iron, Liber 1, Page 133 of Surveys, Manistee County.
1995 Survey by B. J. Jenema PS 25850 found 3/4" pipe.
1997 Survey by Neil B. Llvasy PS 31611 Survey of Part of the Northwest Quarter, no references. Shows a distance of 2645.29' to L-01, N 1/4 of Section 1.

B. Description of corner evidence found and/or method applied in restoring or reestablishing corner:

K-01 Closing Corner of Sections 1 and 2, T24N, R13W and Standard Corner of Sections 35 and 36 T25N, R13W. Found 1" X 6" iron pin 3" below surface of paved road at the intersection of Viaduct and Lindy Roads of Manistee County. 10" below road surface recovered plow point. Recovered references 8 and 10, see Part C. Also recovered a 3/4" X 24" iron pipe (marking rd R/W) to the NW 47.47', a capped 1/2" rebar (marking rd. R/W) to SW 46.48', a Jack Pine BT to the NE and a Pk in PP to NW see part C references 11, 12, 13 and 14 for bearings and distances. References 1, 2, 3, 4, 5, 6, 7 and 9 are gone. Dinger Road runs North between Sections 35 & 36 in Benzie County.

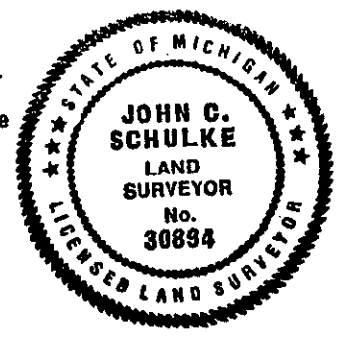

Corner K-01 ratified by the Manistee County Peer Group according to the county plan adopted pursuant to P.A. 345 of 1990, as amended, (being the State Survey and Re-monument Act, MCL 54.261 et seq.). Date of Peer Review: Anthony M. Naumaleski

SEP 07 1999

C. Description of monument for corner and accessories established to perpetuate locating the position of the corner:

- K-01 Closing Corner of Sections 1 and 2, T24N, R13W. Accepted the plow point raised by the pin as the best available evidence of the position of the original corner and on May 27th, 1999 replaced with a Standard Manistee County monument stamped to identify the corner in monument box. References:
(8) 4" X 4" Post N 36° W 47.63 feet (nail to NE, with telephone box on S side of post)
(10) Stop Sign S 20° E 44.4 feet (center of post)
(11) 3/4" X 24" pipe N 40° W 47.47 feet
(12) 1/2" capped rebar S 40° E 46.48 feet PLS 31611 (Neil B. Llvasy)
(13) Jack Pine 14" N 32° E 93.61 feet (Found nail 7' above ground SE side, set 60d SE. 1' above ground)
(14) Power Pole N 62° W 184.90 feet (Fd. Pk nail NE) Line Intersection Pole.

Signed by John C. Schulke

Date September 7th, 1999

Surveyor's Michigan License No. 30894