

LAND CORNER RECORDATION CERTIFICATE

Filing Requirement of Act 74, Mich. P.A. 1970

corners in Manistee County Located In: _____ Corner Code # _____
 (County)

Public Land Survey T 24N R 13W M-4
 T _____ R _____
 T _____ R _____
 T _____ R _____

Property Controlling S _____ T _____ R _____
 in Section S _____ T _____ R _____

Miscellaneous S _____ T _____ R _____
 Property in Section S _____ T _____ R _____

**REGISTER'S OFFICE
 MANISTEE COUNTY**

98-346 AT 11:57 A.M.
AUG 17 1998

Living A. Popper
REGISTER OF DEEDS

Register of Deeds Stamp & File Number

Lot No. _____, Recorded Plat _____
 Private Claims _____

A	B	C	D	E	F	G	H	I	J	K	L	M
2	6	5	4	3	2	1						
3												
4	7	8	9	10	11	12						
5												
6	18	17	16	15	14	13						
7												
8	19	20	21	22	23	24						
9												
10	30	29	28	27	26	25						
11												
12	31	32	33	34	35	36						
13												

John C. Schulke, in a field survey on May 21st, 19 98
 I hereby certify that under requirements of P.A. 74, Michigan P.A. of 1970, the corner points mentioned in lines 1 and 2 above were in conformance with regulations and rules therefore as required in the current manual of survey instructions of the United States Department of the Interior, Bureau of Land Management or by a decree of a Court of Law and/or that the corner points mentioned in lines 3, 4 and 5 above were in conformance with the rules of the Michigan Board of Professional Surveyors or by a Decree of a Court of Law; established, re-established, monumented, re-monumented, recovered, found as expressed below:

NOTE: Not more than 4 corners, all in the same town and range, may be recorded on this certificate.


A. Description of original monument and accessories and/or subsequent restoration:

M-4 East Quarter Corner of Section 12, T24N, R13W
 1838 John Brink US Deputy Surveyor Set Wood Post. BTs:
 GLO line tree 43.97 ch. Hem. 10" (3.97 ch. = 262")
 44.00 ch. (264") enter swamp courses SE.
 (1) Hemlock 10" S29°W 57 links
 (2) Birch 10" N49°W 25 links
 1976 C. Roser restored 1/4 corner on line between recovered corners at M-3 & M-5 and on line across E-W 1/4 line to W. in Section 12 (see LCRC 77-29, Manistee County). Evidence was recovered at C 1/4, CW 1/16th and CE 1/16th. C. Roser

stated in part B of his LCRC "The quarter corner restored by this procedure fits very definite swamp edge 264' N. per U.S. tie and possible hemlock line tree (stump remains at 262' N.). Any quarter corner position N or W of our position could not possible fit U. S. tie to swamp edge." Set standard Wexford County monument and cedar post w/loc. tag. Center of old N-S Twp. Road Due E. 39'±. References:
 (3) Maple 20" N45°W 50.8 feet
 (4) Maple 12" S60°W 43.4 feet
 (5) Hemlock 12" S08°W 43.9 feet
 (6) Hemlock 13" N48°E 13.2 feet

B. Description of corner evidence found and/or method applied in restoring or reestablishing corner:

M-4 East Quarter Corner of Section 12, T24N, R13W
 Found Wexford County Monument in place with location post to NE.
 References 1 and 2 are gone. BT # 4 broken off, stump is S67°W 44.1 feet.
 BT # 6 now dead, standing N48°E 13.5 feet.
 BTs 3 and 5 were found in good condition, see part C.
 NOTE: H. Bruning computed the corner location, apparently by single proportional measurement between M-3 and M-6, but found no written or physical evidence of anything being set at the site to represent M-4 (See Drawing No. S-F 16874).

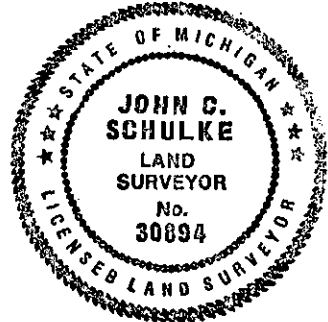

Corner M-04 ratified by the Manistee County Peer Group according to the county plan adopted pursuant to P.A. 345 of 1990, as amended, (being the State Survey and Remonument Act, MCL 54.261 et seq.). Date of Peer Review: JUL 07 1998

C. Description of monument for corner and accessories established to perpetuate locating the position of the corner:

M-4 East Quarter Corner of Section 12, T24N, R13W
 Accepted the location of the Wexford County Monument as the best available evidence of the position of the original corner. References:
 (3) Red Maple 20" N40°W 51.67 feet Set # 60 nail NE. side
 (4) Hemlock 15" S10°W 44.35 feet Set # 60 nail E. side
 (7) Hemlock 4" S82°E 27.67 feet Set # 60 nail NE. side
 (8) Red Maple 17" N85°W 51.67 feet Set # 60 nail N. side
 Cedar Post w. loc. tag Northeast 1 foot

Signed by John C. Schulke
 Surveyor's Michigan License No. 30894

Date July 5th, 1998