

DEC 28 1993

LAND CORNER RECORDATION CERTIFICATE
Filing Requirement of Act 74, Mich. P.A. 1970

SECTION

For corners in

Manistee County (County)

Located In:

Corner Code #

- 1. Public Land Survey T 24N R 13W M-6
2. Property Controlling in Section S T R
3. Miscellaneous Property in Section S T R
4. Lot No. Recorded Plat
5. Private Claims

REGISTER'S OFFICE
MANISTEE COUNTY

98-252 cc 3:45 pm
JUL 01 1998

REGISTER OF DEEDS

Register of Deeds Stamp & File Number

I, John C. Schulke, in a field survey on May 18th, 1998, do hereby certify that under requirements of P.A. 74, Michigan P.A. of 1970, the corner points mentioned in lines 1 and 2 above were in conformance with regulations and rules therefore as required in the current manual of survey instructions of the United States Department of the Interior, Bureau of Land Management or by a decree of a Court of Law and/or that the corner points mentioned in lines 3, 4 and 5 above were in conformance with the rules of the Michigan Board of Professional Surveyors or by a Decree of a Court of Law; established, re-established, monumented, re-monumented, recovered, found as expressed below:

NOTE: Not more than 4 corners, all in the same town and range, may be recorded on this certificate.

Grid table with columns A-M and rows 2-13. Cell (6,13) contains a circled '6'.

A. Description of original monument and accessories and/or subsequent restoration:


M-6 East Quarter Corner of Section 13, T24N, R13W
1838 John Brink US Deputy Surveyor Set Wood Post.
References: Beech 10" S77°W 35 links (1) Beech 16" N72°W 23 links (2)
1903 County Surveyor's Book B, Pages 164 & 165. JHM set 2" bolt for corner by proportional measurement between M-5 & M-7. Set an iron 50 links East (3) Cedar post west 50 links (4)
MCRC corner card, found crank shaft (sta 134+70.55')
Post 4"X 4" Northeast 44.83 feet (5) Pipe Northeast 31.24 feet (6)
Fence Post Southeast 57.38 feet (7) Telephone Pole West 98.77 feet (8)
Continued in part B.

B. Description of corner evidence found and/or method applied in restoring or reestablishing corner:

M-6 East Quarter Corner of Section 13, T24N, R13W
LCRC 75-16 Manistee Co by G. De La Mater recorded 10/20/75, steel rod found.
Power Pole West 98.46 feet (9) Elm 18" N65° 29.00 feet (10) 1975-77
DNR Project # 75-38. Found 2 1/1" shaft in line with fence's to E & W. Replaced with Wexford Co. Mon. Filed LCRC Wexford Co., Liber 3, Page 116-A. References:
Scotch Pine 3" S50°E 67.97 feet (11) Spruce 4" S60°W 59.76 feet (12)
Power Pole N89°W 98.56 feet (9) Set cedar post w/loc. tag Due East 33 feet (13)
Found 2" X 2" pin with a 3" head 15" below road surface in CL of Harlan Road (aka 1 Road Wexford County) and a Wexford County monument 17" below road surface on the East side of the pin. Monument was in unsatisfactory condition with top broken and lower part disintegrating from corrosion (apparently caused by road salt).

C. Description of monument for corner and accessories established to perpetuate locating the position of the corner:

M-6 East Quarter Corner of Section 13, T24N, R13W
Accepted the location of the Wexford County Monument as the best available evidence of the position of the original corner and set a Standard Manistee County monument stamped to identify the corner in a monument box. Reference:
Power Pole S20°W 95.58 feet Fd nail on E. side
White Spruce 8" S55°W 55.55 feet Fd # 60 nail NW side
White Spruce 9" S38°W 100.14 feet Set # 60 nail SE side
Red Pine 8" N37°W 129.32 feet Set # 60 nail NW side
Power Pole, Ch1-15028 N04°W 228.81 feet Set nail E. side
SW corner of house foundation N32°E 206.78 feet

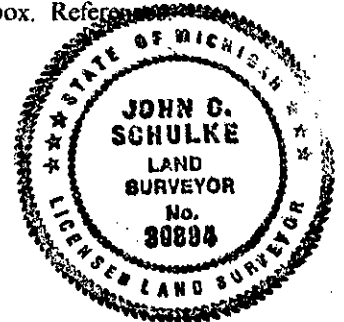

Signed by John C. Schulke Date June 1st, 1998

Surveyor's Michigan License No. 30894

FORM APPROVED BY MICHIGAN STATE BOARD OF PROFESSIONAL SURVEYORS, JAN. 28, 1971
REVISED MAY 14, 1975
REVISED JAN., 1983

Corner M-06 ratified by the Manistee County Peer Group according to the county plan adopted pursuant to P.A. 345 of 1990, as amended, (being the State Survey and Remonument Act, MCL 54.261 et. seq.). Date of Peer Review: JUN. 2 1998