

MICHIGAN
DEPARTMENT OF CONSERVATION
FORESTRY DIVISION

LAND CORNER RECORD

T. 24 N. R. 14W


Manistee COUNTY

DESCRIPTION OF CORNER Section corner common to Sections 20-21-28-29

CORNER MONUMENT 1" pipe with aluminum cap 6" below surface.

DATE MONUMENT PLACED AND WITNESSED 11-2-61

WITNESSES TO CORNER.....

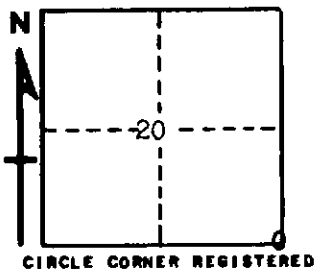

10" Cherry - N 48 W - 107.8 feet

14" Cherry - S 69 W - 69.9 feet

AND

DESCRIPTION IN DETAIL AS TO HOW CORNER WAS LOCATED AND IDENTIFIED OR RESTORED.

This corner was established while making a survey in this township. Unable to locate a previous corner or new bearing trees. Set corner on line over and equidistant from 1/8 and 1/4 corners east. This falls in center of E-W road, and checks Millard's record to W 1/8 between 21-28. This method should place the corner very nearly at the point established in early surveys by Millard and Muenschler. Best available evidence.

SURVEYOR'S SEAL

SIGNED *Kenneth J. Ostling* DATE 11/15/61
REGISTERED LAND SURVEYOR