

MICHIGAN  
DEPARTMENT OF CONSERVATION  
FORESTRY DIVISION

# LAND CORNER RECORD


T. 24 N.R. 14 W  
T 24 NR 15 W Manistee COUNTY

DESCRIPTION OF CORNER 1/4 corner common to Sections 19-24

CORNER MONUMENT 1" pipe with 4" aluminum cap

DATE MONUMENT PLACED AND WITNESSED 8/21/61

WITNESSES TO CORNER.....

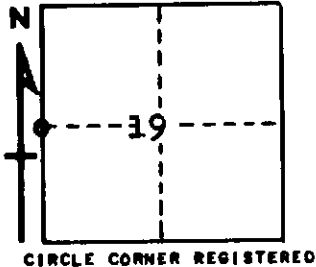

8" Cherry	-	N9W	-	57.8 feet
8" Aspen	-	S41E	-	2.7 feet
AND Center of trail	-	S65W	-	17.5 feet

DESCRIPTION IN DETAIL AS TO HOW CORNER WAS LOCATED AND IDENTIFIED OR RESTORED.

This corner was set by proportionate measurement, midpoint on line between section corners, while making a survey in this area. Falls nearly in line with old fence line west and field edge east. Found one piece of broken glass when setting corner which may place corner in vicinity of the location established in a previous survey by county surveyor.

SURVEYOR'S SEAL

SIGNED Kenneth Ostling DATE 9/25/61  
REGISTERED LAND SURVEYOR