

LAND CORNER RECORDATION CERTIFICATE

FILING REQUIREMENT OF ACT 74, MICH. P.A.1970

FOR CORNERS OF--:	LOCATED IN--:	CORNER CODE NUMBER
1. PUBLIC LAND SURVEY _____	T. 24 N. C-11 R. 14 W.	
2. PROPERTY CONTROLLING IN SECTION <u>20</u>	T. 24 N. R. 14 W.	9; 12
3. MISCELLANEOUS PROPERTY IN SECTION _____	T. _____ N. S. R. _____ E. W.	
4. LOT NO. _____, RECORDED PLAT _____		
5. PRIVATE CLAIMS _____		

REGISTER OF DEEDS STAMP AND FILING NUMBER

I, Carl F. Roser, do hereby certify that under requirements of P.A. 74, Michigan P.A. of 1970, the corner points mentioned in lines 1 and 2 above were, in a field survey on October 10, 1978, established, re-established, monumented, re-monumented, recovered or restored as expressed below and in conformance with regulations and rules therefore as required in the current manual of survey instructions of the United States Department of the Interior, Bureau of Land Management or by a decree of a court of law. Furthermore, that the corner points mentioned in lines 3, 4 and 5 above were, in a field survey on _____, 19____, found, recovered, restored, established or re-established as expressed below and in conformance with the rules of the Michigan State Board of Registration for Land Surveyors or, by a Decree of a Court of law:

A. Description of original monument and accessories and/or subsequent restoration:

B. Description of corner evidence found and/or method applied in restoring or re-establishing corner:


- C-11 Previous Dept. Corner of Record; 1961 (Re-estab. by double proportion).
- 9 Established NE Corner of NW 1/4 of SE 1/4 of Sec. 20 per Std. B.L.M. instructions.
- 12 Established SW Corner of NW 1/4 of SE 1/4 of Sec. 20, per Std. B.L.M. instructions.

C. Description of monument for corner and accessories established to perpetuate locating the position of the corner:

	C-11	9	12
Fd. Dept. Mon & Set Ced. Post.		Drove 5/8"X40" re-rod & Ced. Post w/Loc. Tag.	Set 5/8"X40" re-rod & Ced. Post w/Loc. Tag.
12" Elm	N21°E 31.3		
7" Hemlock	S52°E 34.44	5" R. Pine N15°E 3.5	4" W. Pine N25°E 39.8
7" Hemlock	N60°E 39.2	4" R. Pine S50°E 7.7	8" Maple in clump of 3
4" Cedar	S24°W 100.2	4" R. Pine S70°W 6.7	S60°E 23.7
Fd. Re-rod in Ctr. B. Top			
	N88°30'W 580.55		

SIGNED BY Carl F. Roser DATE 2-26-79

SURVEYOR'S MICHIGAN REGISTRATION NO. 12028

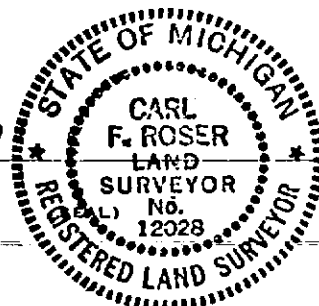

FOR STATE AND UNITED STATES AGENCIES:

SIGNED BY _____ DATE _____
CHIEF OF SURVEY PARTY

APPROVED AND SIGNED BY _____ DATE _____
MICHIGAN REGISTERED LAND SURVEYOR

(SEAL)

SURVEYOR'S MICHIGAN REGISTRATION NO. _____ SPRINGDALE TOWNSHIP
MANISTEE COUNTY