

MICHIGAN
DEPARTMENT OF CONSERVATION
FORESTRY DIVISION

LAND CORNER RECORD

T. 24 N.R. 14 W


Manistee COUNTY

DESCRIPTION OF CORNER Section corner common to Sections: 29 - 30 - 31 - 32

CORNER MONUMENT 1" pipe with 4" brass cap

DATE MONUMENT PLACED AND WITNESSED 12-20-61

WITNESSES TO CORNER.....

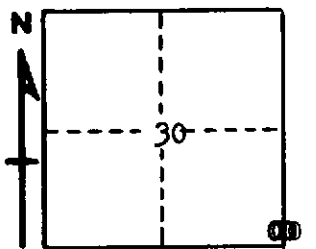

10" Elm - N 17 E - 31.4 feet

6" Hemlock - S 57 E - 34.2 feet

AND 10" Hemlock - S 61 W - 39.8 feet

DESCRIPTION IN DETAIL AS TO HOW CORNER WAS LOCATED AND IDENTIFIED OR RESTORED.

This corner was set by double proportionate measurement between corners 1 mile east, 1 mile west, 2 miles north, 1 mile south. No previous corner. A little short of U. S. record to Bear Creek, but other notes do not check in this area.

SURVEYOR'S SEAL

SIGNED *Kenneth J. Ostling* DATE 12/22/61
REGISTERED LAND SURVEYOR