

LAND CORNER RECORDATION CERTIFICATE
FILING REQUIREMENT OF ACT 74, MICH. P.A.1970

FOR CORNERS OF-- LOCATED IN-- CORNER CODE NUMBER
1. PUBLIC LAND SURVEY T. 24 N. R. 14 W. I-13, J-13
2. PROPERTY CONTROLLING IN SECTION T. S. R. E. W.
3. MISCELLANEOUS PROPERTY IN SECTION T. S. R. E. W.
4. LOT NO. , RECORDED PLAT
5. PRIVATE CLAIMS

REGISTER OF DEEDS STAMP AND FILING NUMBER

I, Carl F. Roser do hereby certify that under requirements of P.A. 74, Michigan P.A. of 1970, the corner points mentioned in lines 1 and 2 above (identified with circles on index code diagram - over) were, in a field survey on 1-9 1973, established, re-established, monumented, re-monumented, recovered or restored as expressed below and in conformance with regulations and rules therefore as required in the current manual of survey instructions of the United States Department of the Interior, Bureau of Land Management or by a decree of a court of law. Furthermore, that the corner points mentioned in lines 3, 4 and 5 above were, in a field survey on 19, found, recovered, restored, established or re-established as expressed below and in conformance with the rules of the Michigan State Board of Registration for Land Surveyors or, by a Decree of a Court of law:

A. Description of original monument and accessories and/or subsequent restoration:

B. Description of corner evidence found and/or method applied in restoring or re-establishing corner:

- I-13 Rewitnesses previous Department corner of record.
J-13 Reestablished corner per standard B.L.M. instructions.

C. Description of monument for corner and accessories established to perpetuate locating the position of the corner:

Table with 2 columns: I-13 and J-13. I-13: Fd. DNR Monument, Added Cedar Guard Post, 8" Tam. N32E 28.6' (old KJO wit), 8" Cedar N14W 26.7', 6" Cedar N51W 29.9' new, NW cor. 8-2 (23-14) West 19.8'. J-13: Set DNR mon & Ced Guard Post, 8" Maple S32E 36.3', 12" Maple S56E 24.1', 16" Maple N43E 27.6', Ctr N-S gravel Rd Due W 17.6', N 1/4 cor 8-2 (23-14) West 11.55'.


SIGNED BY Carl F. Roser DATE 6-15-73

SURVEYOR'S MICHIGAN REGISTRATION NO. 12028

FOR STATE AND UNITED STATES AGENCIES:

SIGNED BY CHIEF OF SURVEY PARTY DATE

APPROVED AND SIGNED BY MICHIGAN REGISTERED LAND SURVEYOR DATE

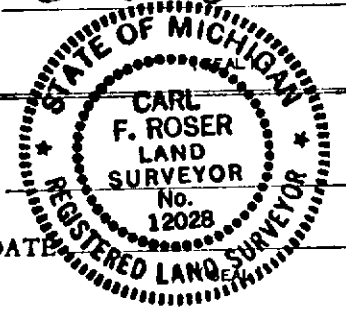

SURVEYOR'S MICHIGAN REGISTRATION NO.