

LAND CORNER RECORDATION CERTIFICATE

FILING REQUIREMENT OF ACT 74, MICH. P.A.1970

FOR CORNERS OF--:	LOCATED IN--:	CORNER CODE NUMBER
1. PUBLIC LAND SURVEY _____	T. <u>24</u> N. <u>0.</u> , R. <u>14</u> W. <u>0.</u>	C-5; C-6; D-5
2. PROPERTY CONTROLLING IN SECTION _____	T. _____ N. _____, R. _____ E. _____ W. _____	_____
3. MISCELLANEOUS PROPERTY IN SECTION _____	T. _____ N. _____, R. _____ E. _____ W. _____	_____
4. LOT NO. _____, RECORDED PLAT _____		
5. PRIVATE CLAIMS _____		

REGISTER OF DEEDS STAMP AND FILING NUMBER

I, Carl F. Roser, do hereby certify that under requirements of P.A. 74, Michigan P.A. of 1970, the corner points mentioned in lines 1 and 2 above were, in a field survey on October 9, 1978, established, re-established, monumented, re-monumented, recovered or restored as expressed below and in conformance with regulations and rules therefore as required in the current manual of survey instructions of the United States Department of the Interior, Bureau of Land Management or by a decree of a court of law. Furthermore, that the corner points mentioned in lines 3, 4 and 5 above were, in a field survey on _____, 19____, found, recovered, restored, established or re-established as expressed below and in conformance with the rules of the Michigan State Board of Registration for Land Surveyors or, by a Decree of a Court of law:

A. Description of original monument and accessories and/or subsequent restoration:

B. Description of corner evidence found and/or method applied in restoring or re-establishing corner:

- C-5 Fd. and accepted 1" pipe. Corner falls in approx. intersection of B.Top roads N-S-E, and ctr. of gravel road to west is 6'+ south. J.H. Millard survey of Sec. 17, 1881 to 1901, calls for Iron Pipe. Fd. 1" pipe also fits Co. Road Comm. Wit. dated 1964; they having found an iron.
 - C-6 Re-established 1/4 Corner on line between Sec. corners to North & South and in line with old fence remains to West (since torn down); which is 1.4'-South of Single Proportion position.
 - D-5 Fd. "PK" in ctr. E-W B.Top Rd. & in line with ctr. of gravel rd. to North & in line with fence remains to South (PK set by F.C.W. 4-26-72). Cor. fits J.H. Millard Survey of Sec. 17, 1881 to 1901.
- C. Description of monument for corner and accessories established to perpetuate locating the position of the corner:

C-5	C-6	D-5
Fd. Cabin Spk. over 1" pipe (2'+ deep) replaced w/5/8"X36" re-rod & plastic Cap.	Drove 5/8"X36" re-rod w/RLS cap. Power Pole N15°W 109.02	Drove 1 1/4"X18" iron rod in ctr. B.Top E-W Co. Rd. P.Pole N25°W 66.13
P.Pole N46°W 90.55	Power Pole S20°W 119.62	7" Tw.CherryS30°W 55.62
5" Trp. W.Birch N68°E 78.11	Set Ced.Post w/Loc. Tag Due E 33'	19" Maple S60°W 118.06
4" Maple(clp.)S24°E 99.34	Ctr. N-S B.Top Rd. Due E 0.3'+	Set Ced.Post w/Loc. Tag Due S 33'
Set Cedar post w/Loc. Tag S45°E 66'		

SIGNED BY Carl F. Roser 2-26-79 DATE _____


SURVEYOR'S MICHIGAN REGISTRATION NO. 12028

FOR STATE AND UNITED STATES AGENCIES:

SIGNED BY _____ DATE _____

APPROVED AND SIGNED BY _____ DATE _____

SURVEYOR'S MICHIGAN REGISTRATION NO. _____

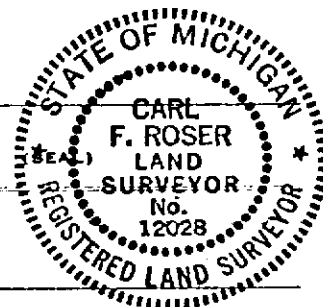

(SEAL)
SPRINGDALE TOWNSHIP
MANISTEE COUNTY