OCT 03 2000

 $\widehat{S^{*}}] = 1, \dots$ 

2

## Filing Requirement of Act 74, Mich. P.A. 1970

_				
$-\alpha$	co	FRA	~~	in
1 (3)	1.1	1115	13	

4. Lot No.

5. Private Claims

Manistee (County)		Located In:	Corner Code #
1. Public Land Survey		T 24N R 15W	M-10
		TR	E¼ Sec 25
		T 24N R 14W	A-10
		T R	W¼ Sec 30
2. Property Controlling	S	TR	
in Section	S	T R	
3. Miscellaneous	s	TR	
Property in Sec.	S	T R	

\_ , Recorded Plat

SECTION

REGISTER'S OFFICE MANISTEE COUNTY SEP 0 3 2000

HONNY a. Pepera REGISTER OF DEEDS

Register of Deeds Stamp & File Number

I, Anthony M. Slawinski, in a field survey on June 27, 20 00 do hereby state that under requirements of P.A. 74, Michigan P.A. of 1970, the corner points mentioned in lines 1 and 2 above were in conformance with regulations and rules therefore as required in the current manual of survey instructions of the United States Department of the Interior, Bureau of Land Management or by a decree of a Court of Law and /or that the corner points mentioned in lines 3, 4 and 5 above were in conformance with the rules of the Michigan Board of Land Surveyors or by a Decree of a Court of Law; established, re-established, monumented, recovered, found as expressed

below: NOTE: Not more than 2 corners, all in the same town and range, may be recorded

- A. Description of original monument and accessories and/or subsequent restoration: East ¼ Corner Section 25 (24-15) & West ¼ Corner Section 30 (24-14) Set by John Brink in 1838
- 1. Hemlock 11" in dia. S 49° W 9 links (5.94')

on this certificate.

2. Hemlock 9" in dia. N 29° W 19 links (12.54')


DNR Survey Map, by Roser in 1978 Fd. ½ "x18" iron rod, replaced 1 ¼ "x18" iron rod Cor. is at south edge E-W dirt road. No witnesses

B. Description of corner evidence found and/or method applied in restoring or reestablishing corner: East 1/4 Corner Section 25 (24-15) & West 1/4 Corner Section 30 (24-14) On June 27, 2000, I, Anthony Slawinski, along with a field crew from the Abonmarche Group found A 1¼" iron rod, 18" long, over a ½" iron rod 18" long. We found no other evidence to dispute this location for

Condition of witnesses: #1 gone, #2 gone

- C. Description of monument for corner and accessories established to perpetuate locating the position of the corner: East ¼ Corner Section 25 (24-15) & West ¼ Corner Section 30 (24-14) On June 27, 2000, I set a Manistee County Monument in the exact location as the above mentioned 1¼" iron rod over the ½" iron rod as a careful and faithful re-establishment of the position of the original corner, and witnessed
- 3. N 31° W 42.81' 30" Triple Maple (fd. nail on SW side of tree)
- 4. N 12° E 42.33' 14" White Pine (set 40d in east side of tree)
- 5. S 19° E 20.87′ 12″ Maple (set 40d in west side of tree)
  6. S 73° W 31.71′ 11″ Maple (set 40d in north side of tree)

DNR Post North +/-7' South of centerline of Norconk road

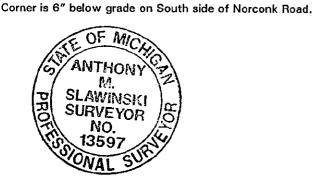

Corner M - 1 0 ratified by the Manistee County Peer Group according to the county plan adopted pursuant to P.A. 345 of 1990, as amended, (being the State Survey and Remonument Act, MCL 54.261 et. seg.). Date of Peer Review: 7-31-60 Guthony m. Slawwhi

Grithony m Surveyor's Michigan License No. 13597

7-26-00