

OCT 03 2000

LAND CORNER RECORDATION CERTIFICATE

Filing Requirement of Act 74, Mich. P.A. 1970

SECTION

For corners in

<u>Manistee</u> (County)	Located In:	Corner Code #
1. Public Land Survey	T <u>24N</u> R <u>15W</u>	<u>M-12</u>
	T _____ R _____	<u>E ¼ Sec 36</u>
	T <u>24N</u> R <u>14W</u>	<u>A-12</u> ✓
	T _____ R _____	<u>W ¼ Sec 31</u>
2. Property Controlling in Section	S _____ T _____ R _____	_____
3. Miscellaneous Property in Sec.	S _____ T _____ R _____	_____
4. Lot No. _____, Recorded Plat _____	S _____ T _____ R _____	_____
5. Private Claims _____	_____	_____

REGISTER'S OFFICE
MANISTEE COUNTY
00-290 PT 10:55 p.m.
SEP 03 2000
Penny A. Lepera
REGISTER OF DEEDS

Register of Deeds Stamp & File Number

I, Anthony M. Slawinski, in a field survey on June 27, 20 00 do hereby state that under requirements of P.A. 74, Michigan P.A. of 1970, the corner points mentioned in lines 1 and 2 above were in conformance with regulations and rules therefore as required in the current manual of survey instructions of the United States Department of the Interior, Bureau of Land Management or by a decree of a Court of Law and/or that the corner points mentioned in lines 3, 4 and 5 above were in conformance with the rules of the Michigan Board of Land Surveyors or by a Decree of a Court of Law; established, re-established, monumented, recovered, found as expressed below:

NOTE: Not more than 2 corners, all in the same town and range, may be recorded on this certificate.

A. Description of original monument and accessories and/or subsequent restoration:
East ¼ Corner section 36 (24-15) & West ¼ Corner Section 31 (24-14)
Set by John Brink in 1838

1. Black Ash 8" in dia. S 25 ½° W 39 links (25.74')
2. Black Ash 8" in dia. N 33° W 10 links (6.60')

Manistee County Surveyor's Record.
By E.W.M. in 1912. (Book A, Page 294)
Found Stake generally accepted as corner.
3. Elm 5" in dia. S 58 ½° W 81 links (53.46')

Certificate of Survey, by Harold R. Bruning in 1978.
Recorded in Liber 1 of surveys, page 529-530
No monuments stated.
No witnesses stated.

B. Description of corner evidence found and/or method applied in restoring or reestablishing corner:
East ¼ Corner section 36 (24-15) & West ¼ Corner Section 31 (24-14)
On June 27, 2000, I, Anthony Slawinski, along with a field crew from the Abonmarche Group found a 5/8" iron rod, 18" long. We found no other evidence to dispute this location for the corner.


Condition of witnesses: #1 gone, #2 gone & #3 gone

C. Description of monument for corner and accessories established to perpetuate locating the position of the corner:
East ¼ Corner section 36 (24-15) & West ¼ Corner Section 31 (24-14)
On June 27, 2000, I set a Manistee County Monument, in the exact location as the above mentioned 5/8" iron rod as a careful and faithful re-establishment of the position of the original corner, and witnessed by:

4. North 29.00' Maple clump (set 40d on west side of clump)
5. N 43° W 45.07' 10" Twin Maple (set 40d on SW side of tree)
6. S 65° W 55.60' 18" Maple (set 60d on N side of tree)
7. S 22° W 52.58' 48" Maple (set 60d on W side of tree)
8. North 20.26' DNR Post (fd. PK nail on E side of post)

Corner is 8" below grade in centerline of Beall road.

Corner M-12
ratified by the Manistee County Peer Group
submitted to the county plan adopted pursuant to P.A. 345 of 1990,
(being the State Survey and Remonument Act, MCL 54.261
(MCL 54.261)). Date of Peer Review: 7-31-00
Anthony M. Slawinski

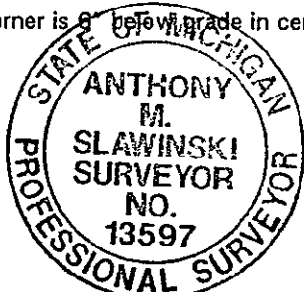

Signed by Anthony M. Slawinski
Surveyor's Michigan License No. 13597

Date 7-26-00

	A	B	C	D	E	F	G	H	I	J	K	L	M
1													
2	6			5		4		3		2		1	
3													
4	7			8		9		10		11		12	
5													
6	18			17		16		15		14		13	
7													
8	19			20		21		22		23		24	
9													
10	30			29		28		27		26		25	
11													
12	31			32		33		34		35		36	
13													