

OCT 03 2000

LAND CORNER RECORDATION CERTIFICATE
Filing Requirement of Act 74, Mich. P.A. 1970

SECTION

For corners in

Manistee (County) Located In: Corner Code #
1. Public Land Survey T 24N R 14W C-13 SE Sec Corner Sec 31
2. Property Controlling in Section S T R NE Sec Corner Sec 6
3. Miscellaneous Property in Sec. S T R
4. Lot No. , Recorded Plat
5. Private Claims

REGISTER'S OFFICE
MANISTEE COUNTY
00-293 Rt 11:08p.m.
SEP 03 2000
Penny A. Pepera
REGISTER OF DEEDS

Register of Deeds Stamp & File Number

I, Anthony M. Slawinski, in a field survey on June 9, 20 00 do hereby state that under requirements of P.A. 74, Michigan P.A. of 1970, the corner points mentioned in lines 1 and 2 above were in conformance with regulations and rules therefore as required in the current manual of survey instructions of the United States Department of the Interior, Bureau of Land Management or by a decree of a Court of Law and/or that the corner points mentioned in lines 3, 4 and 5 above were in conformance with the rules of the Michigan Board of Land Surveyors or by a Decree of a Court of Law; established, re-established, monumented, recovered, found as expressed below:

NOTE: Not more than 2 corners, all in the same town and range, may be recorded on this certificate.

A. Description of original monument and accessories and/or subsequent restoration: Southeast Corner of Section 31 (24-14) & Northeast Corner of Section 6 (23-14) Set by John Brink in 1837.

- 1. Hemlock 14" in dia. N 71° E 42 links (27.72')
2. Hemlock 12" in dia. N 77 1/2° W 80 links (52.80')

- P.A. 74 Form by Jerry L. Wilcox RLS #14102, 1974
Fd. 3/4" rod in E-W road. (74-41)
3. Birch 6" in dia. N 45° E 32.62'
4. Birch 6" in dia. N 25° W 44.20'
5. Fence corner South 76.53'

Survey Map by Wilcox & Associates in 1974
Fd. 3/4" iron rod 2622.20' West of S 1/4 corner of Section 32 (24-14)

B. Description of corner evidence found and/or method applied in restoring or reestablishing corner:


Southeast Sec. Corner Section 31 (24-14) & Northeast Corner of Section 6 (23-14)
On June 9, 2000, I, Anthony M. Slawinski along with a field crew from Abonmarche found a 1 1/2" iron pipe ±16' North of the center line of 13 mile road. The distance between this corner and the South 1/4 corner of Section 32 was checked against the Wilcox distance and it checked to be within 0.24'.

Condition of witnesses: #1 gone, #2 gone, #3 good, #4 gone, #5 gone

C. Description of monument for corner and accessories established to perpetuate locating the position of the corner:
Corner Common to Sections 31 & 32 (24-14) & Sections 5 & 6 (23-14)
On June 9, 2000, I installed a Manistee County Monument in the exact location of the above mentioned 1 1/2" pipe as a careful and faithful re-establishment of the position of the original corner and witnessed by:

- 3. N 45° E 32.56' 12" Birch (Set 60d spike in S. side of tree)
6. N 34° E 24.83' 12" Maple (Fd. Nail & washer on W. side of tree)
7. S 10° E 97.25' 18" Red Pine (Fd. 60d spike on W. side of tree)
8. South 49.41' Iron pipe w/survey cap #13597 on S. R/W of 13 Mile Rd.


Corner is set 6" below grade on the shoulder of 13 mile road, ±16' North of the center line of 13 mile road.

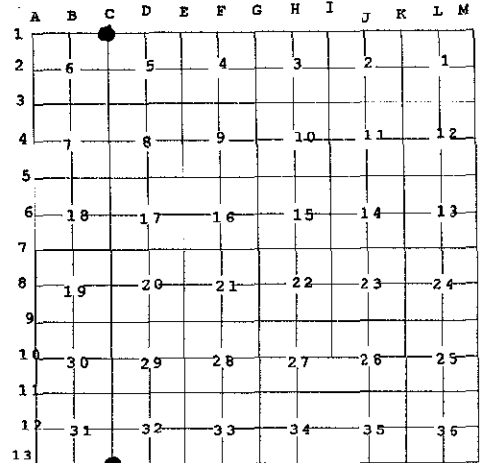

according to the county plan adopted pursuant to P.A. 345 of 1990, as amended, (being the State Survey and Remonument Act, MCL 54.261 et. seq.). Date of Peer Review: 7-31-00
ratified by the Manistee County Peer Group

Anthony M. Slawinski

Signed by Anthony M. Slawinski
Surveyor's Michigan License No. 13597

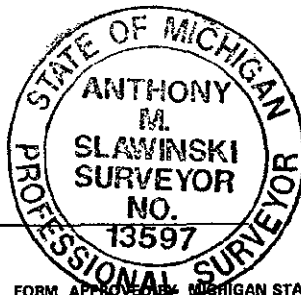

Date 7-26-00