

MAY 16 1997

LAND CORNER RECORDATION CERTIFICATE
Filing Requirement of Act 74, Mich. P.A. 1970

For corners in Manistee (County)

Located in:

Corner Code: #

- 1. Public Land Survey T 24N R 14W D-07 S 1/4 Sec. 17
2. Property Controlling in Section S T R
3. Miscellaneous Property in Sec. S T R

REGISTER'S OFFICE MANISTEE COUNTY

96-473 at 4:00pm OCT 16 1996

REGISTER OF DEEDS


Register of Deeds Stamp & File Number

4. Lot No. Recorded Plat
5. Private Claims

Bruce J. Jenema in a field survey on September 5, 1996

do hereby certify that under requirements of P.A. 74, Michigan P.A. of 1970, the corner points mentioned in lines 1 and 2 above were in conformance with regulations and rules therefore as required in the current manual of survey instructions of the United States Department of the Interior, Bureau of Land Management or by a decree of a Court of Law and/or that the corner points mentioned in lines 3, 4 and 5 above were in conformance with the rules of the Michigan Board of Land Surveyors or by a Decree of a Court of Law; established, re-established, monumented, re-monumented, recovered, found as expressed below:

NOTE: Not more than 4 corners, all in the same town and range, may be recorded on this certificate.

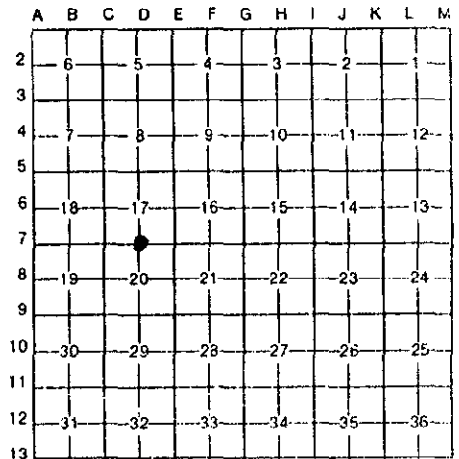

A. Description of original monument and accessories and/or subsequent restoration:

- D-07 S 1/4 Section 17, T24N R14W
John Brink 1839 Deputy Surveyor
(1) W. Pine 10" N65°W 22 links
(2) W. Pine 10" S25°E 19 links
J.H. Millard 1881
Hole with point bits
(3) W. Pine 10" S35°W 22 links
(4) W. Pine 20" N33°W 47 links


- Carl Roser restored this corner by the following method-On line between the SW & the SE corners of Sec. 17 and a prorated distance using Millard(1881-19 for the W 1/2 & US GLO for the E 1/2 Unrecorded LCRC Carl F. Roser 1978 Set DNR monument
(5) 6" W. Pine S57°W 131.20'
(6) 30" W.Pine stp. N27°E 73.20'
(7) Telephone riser S77°E 99.81'
(8) C.L. E-W Earth Rd South 36'

B. Description of corner evidence found and/or method applied in restoring or reestablishing corner:

On August 15, 1996, I found 1" pipe with standard DNR brass cap 36' North of the center line of Glovers Lake Road DNR drawing #78-6

Witnesses 1,2,3,4,6, & 7 are extinct

Corner D-07 ratified by the Manistee County Peer Group according to the county plan adopted pursuant to P.A. 345 of 1990, as amended, (being the State Survey and Monument Act, MCL 54.261 et seq.). Date of Peer Review: SEP 17 1996

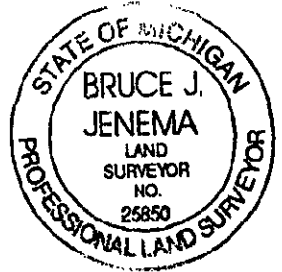

Anthony M. Skowinski

C. Description of monument for corner and accessories established to perpetuate locating the position of the corner:

On August 15, 1996, I found the DNR monument in good condition and is accepted as a careful and faithful re-establishment of the position of original corner and witnessed by:

- (9) 6" R.Pine N72°E 59.00' 60-D N. side
(10) 8" Poplar N38°W 31.64' 60-D S. side
(11) MBT 4x4 S83°E 69.36' 60-D N. side
(12) 6" Poplar S08°W 68.07' 60-D S. side
(5) 14" W.Pine with root & snow blaze S60°W 132.70' set 60-D W. side
Centerline of Glovers Lake Road S00°E 36'

Signed by Bruce J. Jenema
Surveyor's Michigan License No. 25850

Date September 5, 1996