SURVEY & INSTRUMENTATION

MAY 1 6 1997

COMMISSION

LAND CORNER RECORDATION CERTIFICATE

Filing Requirement of Act 74, Mich. P.A. 1970

For corners in Manistee (County)

	Located In:	Corner Code ##
1. Public Land Survey	T 24N R 14W	E-05 SE cor. Sec. 8
	T ___ R ___	
	T ___ R ___	
	T ___ R ___	
2. Property Controlling	S ___ T ___ R ___	
in Section	S ___ T ___ R ___	
3. Miscellaneous	S ___ T ___ R ___	
Property in Sec.	S ___ T ___ R ___	

REGISTER'S OFFICE
MANISTEE COUNTY
96-472 at 3:55pm
OCT 1 6 1996
Deborah Sie
REGISTER OF DEEDS

Register of Deeds Stamp & File Number

4. Lot No. _____, Recorded Plat _____
5. Private Claims _____

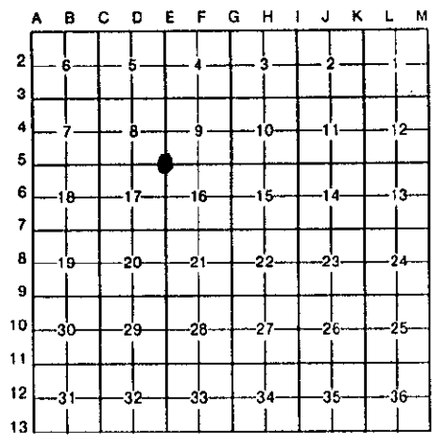

I, Bruce J. Jenema, in a field survey on September 5, 19 96, do hereby certify that under requirements of P.A. 74, Michigan P.A. of 1970, the corner points mentioned in lines 1 and 2 above were in conformance with regulations and rules therefore as required in the current manual of survey instructions of the United States Department of the Interior, Bureau of Land Management or by a decree of a Court of Law and/or that the corner points mentioned in lines 3, 4 and 5 above were in conformance with the rules of the Michigan Board of Land Surveyors or by a Decree of a Court of Law; established, re-established, monumented, re-monumented, recovered, found as expressed below:

NOTE: Not more than 4 corners, all in the same town and range, may be recorded on this certificate.

A. Description of original monument and accessories and/or subsequent restoration:

E-05 SE corner of Section 8, T24N, R14W
John Brink 1839 Deputy Surveyor
(1) 12" Hemlock N14°E 29 links (2) 10" Beech N05°W 52 links (1 & 2 now extinct)
1915 J.H. Millard Book A page 267
(3) 20" Hemlock S49°E 23 links (now extinct)
DNR LCRC 1972 corner restored from Bill Batzer RLS & Road Commission witnesses
Set 3/4x30" Iron Pipe
(4) 6" R. Pine N08°E 114.85' (5) P.Pole N16"E 66.72'
(6) Centerline of Road North 9.6' (7) 6" R.Pine N60°E 115.00'

B. Description of corner evidence found and/or method applied in restoring or reestablishing corner:

On Aug. 15,1996, I found a 3/4"x30" iron pipe.

Corner E - 05 ratified by the Manistee County Peer Group according to the county plan adopted pursuant to P.A. 345 of 1990, as amended, (being the State Survey and Remonument Act, MCL 54.261 et. seq.). Date of Peer Review: SEP 1 7 1996
Anthony M. Skowinski

C. Description of monument for corner and accessories established to perpetuate locating the position of the corner:

On Aug. 15,1996, I installed a Manistee County Monument, within a monument box in the exact location of the above 3/4"x30" iron pipe
as a careful & faithful re-establishment of the position of the original corner and witnessed by:

(4)	Fnd. 15" R. Pine	N11°E	114.80'
(5)	Fnd. P. Pole	N19°E	66.22'
(6)	Center line Road	North	9.5'
(7)	Fnd. 14" R. Pine	N63°E	115.00'
(8)	Fnd. 12" Elm	N55°E	64.70'

Signed by Bruce J. Jenema Date September 5, 1996
Surveyor's Michigan License No. 25850

STATE OF MICHIGAN BRUCE J. JENEMA LAND SURVEYOR NO. 25850 PROFESSIONAL LAND SURVEYOR

FORM APPROVED BY MICHIGAN STATE BOARD OF LAND SURVEYORS, JAN. 28, 1971
REVISED MAY 14, 1975
REVISED JAN., 1983