

JUL 03 2000

### LAND CORNER RECORDATION CERTIFICATE Filing Requirement of Act 74, Mich. P.A. 1970

SECTION

For corners in

<u>Manistee</u> (County)	Located In:	Corner Code #
1. Public Land Survey	T <u>24N</u> R <u>14W</u>	E-13
	T _____ R _____	SE Sec Corner
	T _____ R _____	Sec 32
	T _____ R _____	
2. Property Controlling in Section	S _____ T _____ R _____	
	S _____ T _____ R _____	
3. Miscellaneous Property in Sec.	S _____ T _____ R _____	
	S _____ T _____ R _____	
4. Lot No. _____, Recorded Plat _____		
5. Private Claims _____		

**REGISTER'S OFFICE  
MANISTEE COUNTY**  
00-295 at 11:17 p.m.  
**SEP 03 2000**  
*Penny A. Repora*  
**REGISTER OF DEEDS**

Register of Deeds Stamp & File Number

I, Anthony M. Slawinski, in a field survey on June 9, 20 00 do hereby state that under requirements of P.A. 74, Michigan P.A. of 1970, the corner points mentioned in lines 1 and 2 above were in conformance with regulations and rules therefore as required in the current manual of survey instructions of the United States Department of the Interior, Bureau of Land Management or by a decree of a Court of Law and /or that the corner points mentioned in lines 3, 4 and 5 above were in conformance with the rules of the Michigan Board of Land Surveyors or by a Decree of a Court of Law; established, re-established, monumented, recovered, found as expressed below:

**NOTE: Not more than 2 corners, all in the same town and range, may be recorded on this certificate.**

**A. Description of original monument and accessories and/or subsequent restoration:**

Southeast Section Corner Section 32 (24-14)  
Set by John Brink in 1837.  
1. Sugar 14" in dia. N 63° E 18 links (11.88')  
2. Hemlock 16" in dia. N 45° W 30 links (19.80')  
Brink set the Northeast corner of section 5 (23-14) West, 58 links (32.28')

Manistee County Surveyor's Record  
By Millard in 1913 in section 5 of T23N, R14W Book 4, p 196  
Map shows distance between closing corner & standard Corner. No monument stated nor any witnesses.

Survey Map for MOCO Production Company  
By J.L. Wilcox & Associates in 1974.  
Set 1/2" Iron Double Proportion against Millard  
No Witnesses

**B. Description of corner evidence found and/or method applied in restoring or reestablishing corner:**

Southeast Section Corner Section 32 (24-14)  
On June 9, 2000, I, Anthony M. Slawinski along with a field crew from Abonmarche found 5/8" iron rod in a monument box. We found no other evidence to dispute this location for the corner.

Condition of witnesses: #1 gone & #2 gone


**C. Description of monument for corner and accessories established to perpetuate locating the position of the corner:**

Southeast Section Corner Section 32 (24-14)  
On June 9, 2000, I placed a Manistee County Monument, in a monument box in the exact location as the above mentioned 5/8" iron rod as a careful and faithful re-establishment of the position of the original corner, and witnessed by:

3. N 16° W 41.52' 18" triple Cedar (fd. doubleheaded nail in SW. side of tree)
4. S 62° W 79.63' 8" Maple (set 60d in N side of tree)
5. S 19° E 51.90' 24" White Pine (set 60d in W side of tree)
6. N 37° E 48.92' 8" Poplar (set 60d in E side of tree)

Corner is in the centerline of 13 Mile Road. Closing Corner is 38.28' West, being the NE Sec. Cor of Sec 5 (23-14)

	A	B	C	D	E	F	G	H	I	J	K	L	M
1													
2	6		5		4		3		2		1		
3													
4	7		8		9		10		11		12		
5													
6	18		17		16		15		14		13		
7													
8	19		20		21		22		23		24		
9													
10	30		29		28		27		26		25		
11													
12	31		32		33		34		35		36		
13													

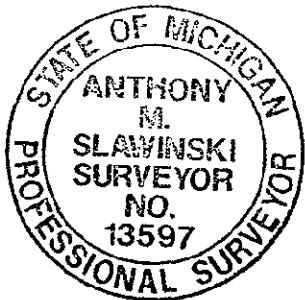

Corner E - 13 ratified by the Manistee County Peer Group according to the county plan adopted pursuant to P.A. 345 of 1990, as amended, (being the State Survey and Remonument Act, MCL 54.261 et seq.). Date of Peer Review: 7-31-00  
*Anthony M. Slawinski*

Signed by Anthony M. Slawinski

Date 7-26-00

Surveyor's Michigan License No. 13597