SURVEY &
REMONUMENTATION

MAY 1 6 1997

COMMISSION

LAND CORNER RECORDATION CERTIFICATE

Filing Requirement of Act 74, Mich. P.A. 1970

For corners in Manistee (County)

	Located In:	Corner Code ##
1. Public Land Survey	T 24N R 14W	F-07 S¼ Sec. 16
	T ___ R ___	
	T ___ R ___	
	T ___ R ___	
2. Property Controlling	S ___ T ___ R ___	
in Section	S ___ T ___ R ___	
3. Miscellaneous	S ___ T ___ R ___	
Property in Sec.	S ___ T ___ R ___	

REGISTER'S OFFICE
MANISTEE COUNTY
96-469 at 3:40 pm
OCT 16 1996
Deborah Dix
REGISTER OF DEEDS

Register of Deeds Stamp & File Number

4. Lot No. _____, Recorded Plat _____
5. Private Claims _____

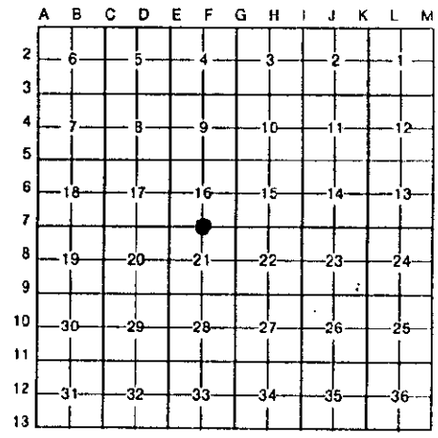

I, Bruce J. Jenema, in a field survey on September 5, 19 96, do hereby certify that under requirements of P.A. 74, Michigan P.A. of 1970, the corner points mentioned in lines 1 and 2 above were in conformance with regulations and rules therefore as required in the current manual of survey instructions of the United States Department of the Interior, Bureau of Land Management or by a decree of a Court of Law and/or that the corner points mentioned in lines 3, 4 and 5 above were in conformance with the rules of the Michigan Board of Land Surveyors or by a Decree of a Court of Law; established, re-established, monumented, re-monumented, recovered, found as expressed below:

NOTE: Not more than 4 corners, all in the same town and range, may be recorded on this certificate.

A. Description of original monument and accessories and/or subsequent restoration:

F-07 S 1/4 corner of Section 16, T24N, R14W
John Brink Deputy Surveyor 1839
(1) 8" Beech S24°W 46 links (2) 9" Beech N22°W 31 links
J.H. Millard May 1899 Book B page 52 Found stake & BT bearing tree
(3) 12" sugar N07°E 13 links 11-15-1961 DNR Land corner record set 1"x24" pipe
Corner on line between section corners at Millards record distances
(4) 10" Cherry N27°W 60.0' (5) 12" Elm N59"E 90.0'
Slawinski 1972 witnessed: (4), (5) in addition to the following
(6) conc. mon. N10°E 32.03 ft. (7) P.Pole N45°E 45.21'(8) 4" Pine South 42.39'

B. Description of corner evidence found and/or method applied in restoring or reestablishing corner:

On August 26,1996, I found a 1"x24" Iron Pipe with 1/2" iron with cap inside.

Witnesses 6 & 7 were found in good condition and verified.

Witnesses 1,2,3,4, & 5 are extinct.

Corner F-07 ratified by the Manistee County Peer Group according to the county plan adopted pursuant to P.A. 345 of 1990, as amended, (being the State Survey and Remonument Act, MCL 54.261 et. seq.). Date of Peer Review: SEP 17 1996
Anthony W. Slawinski

The DNR re-established this corner on line between section corners at Millards measurements for the East 1/2 mile 40.46 chs.

C. Description of monument for corner and accessories established to perpetuate locating the position of the corner:

On Aug. 26,1996, I installed a Manistee County Monument, within a monument box in the exact location of the above 1"x24" iron pipe and is accepted as a careful & faithful re-establishment of the position of the original corner and witnessed by:
(6) & (7) were found in good condition
(8) 12" W.Pine S13°30'E 43.04' Fnd.
(9) 12" W. Pine S12°W 42.00' Fnd.

STATE OF MICHIGAN
BRUCE J. JENEMA
LAND SURVEYOR NO. 25850
PROFESSIONAL LAND SURVEYOR

Signed by Bruce J. Jenema Date September 5,1996
Surveyor's Michigan License No. 25850

FORM APPROVED BY MICHIGAN STATE BOARD OF LAND SURVEYORS, JAN. 28, 1971
REVISED MAY 14, 1975
REVISED JAN., 1983