

JUL 03 2000

### LAND CORNER RECORDATION CERTIFICATE Filing Requirement of Act 74, Mich. P.A. 1970

For corners in

Manistee _____ (County)	Located In:	Corner Code #
1. Public Land Survey	T <u>24N</u> R <u>14W</u>	<u>F-13</u>
	T _____ R _____	<u>S 1/4 Sec 33</u>
	T _____ R _____	_____
	T _____ R _____	_____
2. Property Controlling in Section	S _____ T _____ R _____	_____
	S _____ T _____ R _____	_____
3. Miscellaneous Property in Sec.	S _____ T _____ R _____	_____
	S _____ T _____ R _____	_____
4. Lot No. _____, Recorded Plat _____		
5. Private Claims _____		

**REGISTER'S OFFICE  
MANISTEE COUNTY**  
00-296 at 11:20 p.m.  
**SEP 03 2000**  
*Penny A. Pepera*  
**REGISTER OF DEEDS**

Register of Deeds Stamp & File Number

I, Anthony M. Slawinski, in a field survey on June 9 20 00 do hereby state that under requirements of P.A. 74, Michigan P.A. of 1970, the corner points mentioned in lines 1 and 2 above were in conformance with regulations and rules therefore as required in the current manual of survey instructions of the United States Department of the Interior, Bureau of Land Management or by a decree of a Court of Law and /or that the corner points mentioned in lines 3, 4 and 5 above were in conformance with the rules of the Michigan Board of Land Surveyors or by a Decree of a Court of Law; established, re-established, monumented, recovered, found as expressed below:

**NOTE: Not more than 2 corners, all in the same town and range, may be recorded on this certificate.**

**A. Description of original monument and accessories and/or subsequent restoration:**

South 1/4 Corner Section 33 (24-14)

Set by John Brink in 1837.

1. Beech 8" in dia. N 50° E 27links (17.82')
2. Beech 8" in dia. N 42° W 40 links (26.40')

Manistee County Surveyor's Record Book A, p. 195  
By Millard in 1914 in section 4 of T23N, R14W  
No monument was stated nor witnesses

Survey Map by J.L. Wilcox & Associates in 1974  
"Set Bolt Spike Double Proportion against Millard"  
No Witnesses

**Certificate of Survey**

By Anthony M. Slawinski in 1983.

Fd. 1/2" Iron

3. Guy Pole N 50° E 57.10'
4. Telephone Pole S 40° E 50.08'

**B. Description of corner evidence found and/or method applied in restoring or reestablishing corner:**

South 1/4 Corner Section 33 (24-14)

On June 9, 2000, I, Anthony M. Slawinski along with a field from Abonmarche found a 5/8" iron rod in a monument box in the intersection of 13 Mile road and Healy Lake road. We found no other evidence to dispute the location of the corner.

Condition of witnesses: #1 gone, #2 gone, #3 gone & #4 gone

**C. Description of monument for corner and accessories established to perpetuate locating the position of the corner:**

South 1/4 Corner Section 33 (24-14)

On June 9, 2000, I installed a Manistee County Monument, within a monument box at the exact location of the above mentioned 5/8" iron rod, as a careful and faithful re-establishment of the position of the original corner, and witnessed by:


5. N 35° W 59.60' Power pole (fd. 60d spike in SW. side of pole)
6. S 57° W 58.11' Fence Post (set 60d spike in N. side of post)
7. S 40° E 48.23' Fence Post (set 60d spike in SW. side of post)
8. N 55° E 48.23' Wooden Sign Post (set 60d spike in N. side of post)

Corner is in the centerline intersection of 13 Mile Road and Healy Lake Road.  
The N 1/4 Corner of Section 4 (23-14) is 10.56' West of this corner.

	A	B	C	D	E	F	G	H	I	J	K	L	M
1													
2	6		5		4		3		2		1		
3													
4	7		8		9		10		11		12		
5													
6	18		17		16		15		14		13		
7													
8	19		20		21		22		23		24		
9													
10	30		29		28		27		26		25		
11													
12	31		32		33		34		35		36		
13													

Corner F-13  
according to the county plan adopted pursuant to P.A. 345 of 1990, as amended (being the State Survey and Remonument Act, MCL 54.261 et seq.). Date of Peer Review: 7-31-00  
ratified by the Manistee County Peer Group

*Anthony M. Slawinski*

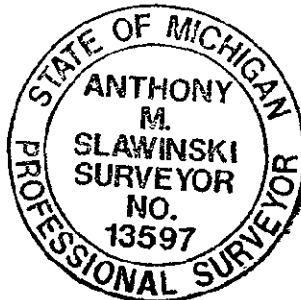

Signed by Anthony M. Slawinski  
Surveyor's Michigan License No. 13597

Date 7-26-00