

2007 08 2000

LAND CORNER RECORDATION CERTIFICATE Filing Requirement of Act 74, Mich. P.A. 1970

SECTION

For corners in

<u>Manistee</u> <small>(County)</small>	Located In:	Corner Code #
1. Public Land Survey	T <u>24N</u> R <u>14W</u>	<u>G-13</u>
	T _____ R _____	<u>SE Sec Corner</u>
	T _____ R _____	<u>Sec 33</u>
	T _____ R _____	_____
2. Property Controlling in Section	S _____ T _____ R _____	_____
	S _____ T _____ R _____	_____
3. Miscellaneous Property in Sec.	S _____ T _____ R _____	_____
	S _____ T _____ R _____	_____
4. Lot No. _____, Recorded Plat _____		
5. Private Claims _____		

REGISTER'S OFFICE
MANISTEE COUNTY

00-297 At 11:25 p.m.
SEP 03 2000

Penny A. Repora
REGISTER OF DEEDS

Register of Deeds Stamp & File
Number

I, Anthony M. Slawinski, in a field survey on June 9, 20 00 do hereby state that under requirements of P.A. 74, Michigan P.A. of 1970, the corner points mentioned in lines 1 and 2 above were in conformance with regulations and rules therefore as required in the current manual of survey instructions of the United States Department of the Interior, Bureau of Land Management or by a decree of a Court of Law and /or that the corner points mentioned in lines 3, 4 and 5 above were in conformance with the rules of the Michigan Board of Land Surveyors or by a Decree of a Court of Law; established, re-established, monumented, recovered, found as expressed below:

NOTE: Not more than 2 corners, all in the same town and range, may be recorded on this certificate.

A. Description of original monument and accessories and/or subsequent restoration:

- Southeast Section Corner Section 33 (24-14)
Set by John Brink in 1837.
- 1. Sugar 12" in dia. N 18 1/2° E 48 links (31.68')
- 2. Hemlock 10" in dia. N 69° W 26 links (17.16')
- Brink set Northeast corner of section 4 (23-14) West, 45 links (29.70')

Manistee County Surveyor's Record
Unknown Surveyor found stakes in 1911.
Book A, page 279

Manistee County Surveyor's Record
By Millard in 1914 in section 4 T23N, R14W
No monuments stated nor witnesses. *Book A, Page 195*

Survey Map for MOCO Production Company
By J.L. Wilcox & Associates in 1974
Set 1/2" Iron Double Proportion against Millard
No Witnesses

Certificate of Survey
By Anthony M. Slawinski in 1983.
Fd. 1/2" Iron Rod with yellow cap #14102 (Wilcox)
No witnesses

B. Description of corner evidence found and/or method applied in restoring or reestablishing corner:

Southeast Section Corner Section 33 (24-14)
On June 9, 2000, I, Anthony M. Slawinski along with a field crew From Abonmarche found a 1/2" iron rod.
We found no other evidence to dispute this location for the corner.


Condition of witnesses: #1 gone, #2 gone

C. Description of monument for corner and accessories established to perpetuate locating the position of the corner:

Southeast Section Corner Section 33 (24-14)
On June 9, 2000, I placed a Manistee County Monument in the exact location of the above mentioned 1/2" iron rod as a careful and faithful re-establishment of the position of the original corner and witnessed by:

- 3. N 50° W 3.92' 15" twin Maple (fd. overgrown nail on S. side of tree)
- 4. West 29.70' closing corner for section 4 (23-14), 1/2" iron rod
- 5. S 43° E 19.43' 6" Cherry (fd. overgrown nail in SW. side of tree)
- 6. N 66° E 25.00' 8" Maple (fd. overgrown nail in N. side of tree)

Corner is 6" above grade.
Corner is ±200' south of 13 Mile Road

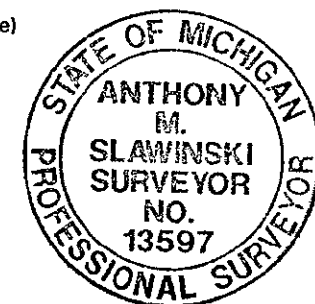

Corner G-13 ratified by the Manistee County Peer Group according to the county plan adopted pursuant to P.A. 345 of 1990, as amended, (being the State Survey and Remonument Act, MCL 54.261 et. seq.) . Date of Peer Review: 7-31-00

Anthony M. Slawinski

	A	B	C	D	E	F	G	H	I	J	K	L	M
1													
2	6		5		4		3		2		1		
3													
4	7		8		9		10		11		12		
5													
6	18		17		16		15		14		13		
7													
8	19		20		21		22		23		24		
9													
10	30		29		28		27		26		25		
11													
12	31		32		33		34		35		36		
13													

Signed by *Anthony M. Slawinski*
Surveyor's Michigan License No. 13597

Date 7-26-00