OCT 0 3 2000

SECTION

LAND CORNER RECORDATION CERTIFICATE

Filing Requirement of Act 74, Mich. P.A. 1970

For corners in

Manistee (County)

	Located In:	Corner Code #
1. Public Land Survey	T 24N R 14W	I-13
	T____ R____	SE Sec Corner
	T____ R____	Sec 34
	T____ R____	
2. Property Controlling	S____ T____ R____	
in Section	S____ T____ R____	
3. Miscellaneous	S____ T____ R____	
Property in Sec.	S____ T____ R____	

4. Lot No. _____, Recorded Plat _____

5. Private Claims _____

REGISTER'S OFFICE
MANISTEE COUNTY
00-298 At 11:27 p.m.
SEP 0 3 2000
Penny A. Pepera
REGISTER OF DEEDS

Register of Deeds Stamp & File Number

I, Anthony M. Slawinski, in a field survey on June 9, 20 00 do hereby state that under requirements of P.A. 74, Michigan P.A. of 1970, the corner points mentioned in lines 1 and 2 above were in conformance with regulations and rules therefore as required in the current manual of survey instructions of the United States Department of the Interior, Bureau of Land Management or by a decree of a Court of Law and /or that the corner points mentioned in lines 3, 4 and 5 above were in conformance with the rules of the Michigan Board of Land Surveyors or by a Decree of a Court of Law; established, re-established, monumented, recovered, found as expressed below:

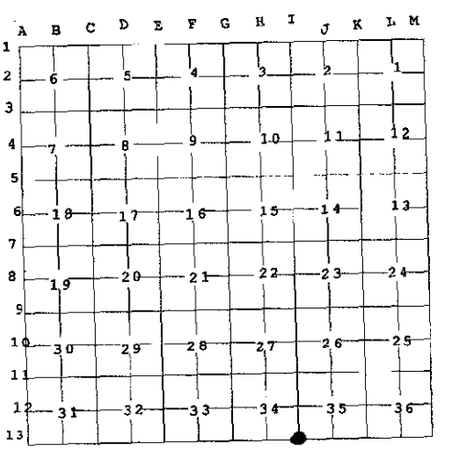

NOTE: Not more than 2 corners, all in the same town and range, may be recorded on this certificate.

A. Description of original monument and accessories and/or subsequent restoration:

Southeast Section Corner Section 34 (24-14)
Set by John Brink in 1837.
1. Cedar 9" in dia. N 19° E 31 links (20.46')
2. Cedar 10" in dia. N 54° W 37 links (24.42')
4 chains West intersected a stream 15 links wide (9.9')
Brink set the Northeast corner of section 3 (23-14) West, 30 links (19.80')

P.A. 74 form by Carl F. Roser, 1973
Fd. DNR Monument, Added Cedar Guard Post
3. Tamarack 8" in dia. N32° E 28.60' (old KJO wit) (Ostling)
4. Cedar 8" in dia. N 14° W 26.70' (old KJO wit) (Ostling)
5. Cedar 6" in dia. N 51° W 29.90' new
6. NW Cor. S-2 (23-14) West 19.80'

Survey Map for MOCO Production Company
By J.L. Wilcox & Associates in1974
Fd. DNR monument

Corner I - 13 ratified by the Manistee County Peer Group according to the county plan adopted pursuant to P.A. 345 of 1990, as amended, (being the State Survey and Remonument Act, MCL 54.261 et. seq.). Date of Peer Review: 7-31-00
Anthony M. Slawinski

P.A. 74 form by John I. Nelson, 1975. Recorded 75-44 (Manistee County records)
Fd. D.N.R Brass Plaque as set by C. Roser, R.L.S. #12028, and recorded in Liber 73, Page 170, Manistee County Records.
3. Fd. Blaze 8" Tamarack N 32° E 28.60'
4. Fd. Blaze 8" Cedar N 14° W 26.70'
5. Fd. Blaze 8" Cedar N 51° W 29.90'
7. Set Nail w/R.L.S. Tag South side 8" Cedar (Azimuth) 264° 18.45'
5. Set Nail w/R.L.S. Tag Southwest side 8" Cedar (Azimuth) 309° 30.34'
4. Set Nail w/R.L.S. Tag West side 8" Cedar (Azimuth) 350° 27.00'
D.N.R. Monument at NE Corner of Section 3 (T.23N, R.14W)

P.A. 74 form by Robert F. Mitchell, 1988 (Rec. 88-718)
Set 6' long "T" fence post on west edge of Lemon Creek
4. Cedar 8" in dia. N 10° W 27.00' scribed "NBT".
5. Cedar 8" in dia. N 51° W 30.34'
7. Cedar 8" in dia. S. 86° W 18.45'

B. Description of corner evidence found and/or method applied in restoring or reestablishing corner:

Southeast Section Corner Section 34 (24-14)
On June 9, 2000, I Anthony M. Slawinski along with a field crew from Abonmarche found a "T" fence post that was set by Mitchell in the West side of Lemon Creek. We found no other evidence to dispute this location for the corner. The fence post is in Lemon Creek

Condition of witnesses: #1 gone, #2 gone, #3 fd. dead, #4 fd. dead, # 5 good, #6 good, #7 fd. dead

C. Description of monument for corner and accessories established to perpetuate locating the position of the corner:

Southeast Section Corner Section 34 (24-14)
On June 9, 2000, I accepted the above mentioned "T" fence post as a careful and faithful re-establishment of the position of the original corner. A Manistee County Monument was not placed in the creek for fear it would wash out like the previous DNR Monument. The fence post is witnessed by:

3. N 32° E 28.60' 8" Tamarack (fd. nail on W. side of tree)
4. N 14° W 26.70' 8" Cedar (fd nail on E, side of tree)
5. N 51° W 30.34' 8" Cedar (fd. old nail on S. side of tree)
6. West 19.80' NW Corner of Section 2 (23-14) (DNR Brass Disc)
Corner is in Lemon Creek. Northeast corner of section 4 T23N, R14W is West, 19.80'

Signed by Anthony M. Slawinski Date 7-26-00
Surveyor's Michigan License No. 13597

STATE OF MICHIGAN
ANTHONY M. SLAWINSKI
SURVEYOR
NO. 13597
PROFESSIONAL SURVEYOR

FORM APPROVED BY MICHIGAN STATE BOARD OF PROFESSIONAL SURVEYORS, JAN. 28, 1971
REVISED MAY 14,1975
REVISED JAN., 1983
REVISED OCT., 1995