

JUL 03 2000

LAND CORNER RECORDATION CERTIFICATE

Filing Requirement of Act 74, Mich. P.A. 1970

SECTION

For corners in

<u>Manistee</u> (County)	Located In:	Corner Code #
1. Public Land Survey	T <u>24N</u> R <u>14W</u>	<u>M-02</u> ✓
	T _____ R _____	<u>E ¼ Sec 1</u>
	T <u>24N</u> R <u>13W</u>	<u>A-02</u>
	T _____ R _____	<u>W ¼ Sec 6</u>
2. Property Controlling in Section	S _____ T _____ R _____	
	S _____ T _____ R _____	
3. Miscellaneous Property in Sec.	S _____ T _____ R _____	
	S _____ T _____ R _____	
4. Lot No. _____, Recorded Plat _____		
5. Private Claims _____		

REGISTER'S OFFICE
MANISTEE COUNTY

00-301 AT 11:40p.m.
SEP 03 2000

Penny A. Repora
REGISTER OF DEEDS

Register of Deeds Stamp & File Number

I, Anthony M. Slawinski, in a field survey on June 7, 2000 do hereby state that under requirements of P.A. 74, Michigan P.A. of 1970, the corner points mentioned in lines 1 and 2 above were in conformance with regulations and rules therefore as required in the current manual of survey instructions of the United States Department of the Interior, Bureau of Land Management or by a decree of a Court of Law and /or that the corner points mentioned in lines 3, 4 and 5 above were in conformance with the rules of the Michigan Board of Land Surveyors or by a Decree of a Court of Law; established, re-established, monumented, recovered, found as expressed below:

	A	B	C	D	E	F	G	H	I	J	K	L	M
1													
2	6		5		4		3		2				
3													
4	7		8		9		10		11		12		
5													
6	18		17		16		15		14		13		
7													
8	19		20		21		22		23		24		
9													
10	30		29		28		27		26		25		
11													
12	31		32		33		34		35		36		
13													

NOTE: Not more than 2 corners, all in the same town and range, may be recorded on this certificate.

A. Description of original monument and accessories and/or subsequent restoration:

East ¼ Corner Section 2 (24-14)

Set by John Brink in 1837.

- 1. Hemlock 8" in dia. S 44° W 20 links (13.20')
- 2. Sugar 9" in dia. N 57° W 35 links (23.10')

Copy of Minutes of Survey in 1907 by Millard.

Fd. Part of stake and Bearing Tree stumps

Set stone. (Book B, Page 68)

- 3. Telephone Pole 10" in dia. N 19° E 109½ links (72.27')
- 4. Telephone Pole 8" in dia. S 23° E 113½ links (74.91')

Certificate of Survey by Anthony M. Slawinski in 1981.

Fd. Nothing, computed and set 1 ¼" Iron Pipe.

By pro-rating against G.L.O.

- 5. Red Pine 4" in dia. N 70° E 73.91'
- 6. White Pine 6" in dia. S 30° E 91.15'
- 7. Cherry 16" in dia. S 40° W 66.95'
- 8. J. Pine 8" in dia. N 66° W 83.70'

Corner M - D 2

ratified by the Manistee County Peer Group according to the county plan adopted pursuant to P.A. 345 of 1990, as amended, (being the State Survey and Remonument Act, MCL 54.261 et. seq.). Date of Peer Review: 7-31-00

Anthony M. Slawinski

B. Description of corner evidence found and/or method applied in restoring or reestablishing corner:

East ¼ Corner Section 2 (24-14)

On June 7, 2000, I Anthony M. Slawinski along with a field crew from Abonmarche found a 1 ¼" pipe.

We found no other evidence to dispute this location for the corner.

Condition of witnesses: #1 gone, #2 gone, #3 gone, #4 gone, #5 good, #6 good, #7 good, #8 gone

C. Description of monument for corner and accessories established to perpetuate locating the position of the corner:


East ¼ Corner Section 2 (24-14)

On June 7, 2000, I placed a Manistee County Monument, in a monument box in the exact location as the above

mentioned 1 ¼" pipe as a careful and faithful re-establishment of the position of the original corner, and witnessed by:

- 5. N 70° E 73.91' 10" Red Pine (fd. spike and washer in S. side of tree)
- 6. S 30° E 91.15' 9" White Pine (fd. spike and washer in N. side of tree)
- 7. S 40° W 66.95' 21" Cherry (fd. spike and washer in N. side of tree)
- 9. N 23° W 64.60' 10" Cherry (set 60d in NE side of tree)

Corner is 4' West of the centerline of Thompsonville Rd.

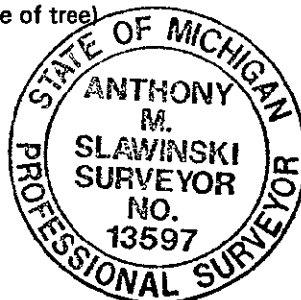

Signed by Anthony M. Slawinski

Date 7-26-00

Surveyor's Michigan License No. 13597