OCT 0 3 2000

SECTION

REGISTER'S OFFICE
MANISTEE COUNTY
00-303 At 11:45 p.m.
SEP 0 3 2000
Penny A. Pepper
REGISTER OF DEEDS

Register of Deeds Stamp & File Number

LAND CORNER RECORDATION CERTIFICATE

Filing Requirement of Act 74, Mich. P.A. 1970

For corners in

Manistee (County) Located In: Corner Code #

1. Public Land Survey T 24N R 14W M-04
   T____ R____ E¼ Sec 12
   T____ R____
   T____ R____
2. Property Controlling S____ T____ R____
   in Section S____ T____ R____
3. Miscellaneous S____ T____ R____
   Property in Sec. S____ T____ R____
4. Lot No. _____ , Recorded Plat _____
5. Private Claims _____

I, Anthony M. Slawinski , in a field survey on June 7, 20 00 do hereby state that under requirements of P.A. 74, Michigan P.A. of 1970, the corner points mentioned in lines 1 and 2 above were in conformance with regulations and rules therefore as required in the current manual of survey instructions of the United States Department of the Interior, Bureau of Land Management or by a decree of a Court of Law and /or that the corner points mentioned in lines 3, 4 and 5 above were in conformance with the rules of the Michigan Board of Land Surveyors or by a Decree of a Court of Law; established, re-established, monumented, recovered, found as expressed below:

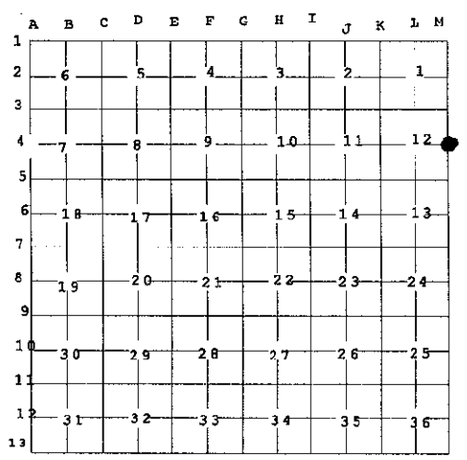

NOTE: Not more than 2 corners, all in the same town and range, may be recorded on this certificate.

A. Description of original monument and accessories and/or subsequent restoration:
East ¼ Corner Section 4 (24-14)
Set by John Brink in 1837.
1. Hemlock 12" in dia. S 73° W 33 links (21.78')
2. Sugar 8" in dia. N 41° W 13 links (8.58')

Manistee County Surveyor's Records (undated)
Unknown surveyor book A, page 264
Fd. Old stake.
1. Hemlock stump 24" in dia. S 70¼° W 31 links (20.46')

Certificate of Survey by Harold Bruning, date unknown
Set 5/8"x24" Iron rod with plastic cap.
No witnesses.

M.D.O.T. R/W Map
No irons stated, No witnesses
undated

Corner M - 0 4 ratified by the Manistee County Peer Group according to the county plan adopted pursuant to P.A. 345 of 1990, as amended, (being the State Survey and Remonument Act, MCL 54.261 et.seq.). Date of Peer Review: 7-31-00
Anthony M. Slawinski

B. Description of corner evidence found and/or method applied in restoring or reestablishing corner:
East ¼ Corner Section 4 (24-14)
On June 7, 2000, I, Anthony M. Slawinski, along with a field crew from Abonmarche found a 5/8" iron rod.
We found no other evidence to dispute this location for the corner.

Condition of witnesses: #1 gone, #2 gone

C. Description of monument for corner and accessories established to perpetuate locating the position of the corner:
East ¼ Corner Section 4 (24-14)
On June 7, 2000, I placed a Manistee County Monument, in a monument box in the exact location as the above mentioned 5/8" iron rod as a careful and faithful re-establishment of the position of the original corner, and witnessed by:

3. N 68° E 114.54' 12" Maple (fd. 60d on W. side of tree)
4. S 13° E 140.98' 8" Maple (fd. 60d on NE side of tree)
5. S 21° W 92.26' Power Pole (fd. 60d on W side of power pole)
6. N 82° W 90.28' Power Pole (fd. 60d on E side of tree)

Corner is in the centerline of Thompsonville Rd. and 45' South of centerline of M-115.

STATE OF MICHIGAN
ANTHONY M. SLAWINSKI
SURVEYOR NO. 13597
PROFESSIONAL SURVEYOR

Signed by Anthony M. Slawinski Date 7-26-00

Surveyor's Michigan License No. 13597

FORM APPROVED BY MICHIGAN STATE BOARD OF PROFESSIONAL SURVEYORS, JAN. 28, 1971
REVISED MAY 14,1975
REVISED JAN., 1983
REVISED OCT., 1995