

OCT 03 2000

LAND CORNER RECORDATION CERTIFICATE
Filing Requirement of Act 74, Mich. P.A. 1970

For corners in

Manistee (County) Located In: Corner Code #
1. Public Land Survey T 24N R 14W M-05 SE Sec Corner Sec 12
2. Property Controlling in Section S T R SW Sec Cor Sec. 7
3. Miscellaneous Property in Sec. S T R
4. Lot No. , Recorded Plat
5. Private Claims

REGISTER'S OFFICE
MANISTEE COUNTY

00-304 AT 11:47 a.m.
SEP 03 2000

Penny A. Repora
REGISTER OF DEEDS

Register of Deeds Stamp & File Number

I, Anthony M. Slawinski, in a field survey on June 7, 2000 do hereby state that under requirements of P.A. 74, Michigan P.A. of 1970, the corner points mentioned in lines 1 and 2 above were in conformance with regulations and rules therefore as required in the current manual of survey instructions of the United States Department of the Interior, Bureau of Land Management or by a decree of a Court of Law and /or that the corner points mentioned in lines 3, 4 and 5 above were in conformance with the rules of the Michigan Board of Land Surveyors or by a Decree of a Court of Law; established, re-established, monumented, recovered, found as expressed below:

NOTE: Not more than 2 corners, all in the same town and range, may be recorded on this certificate.

A. Description of original monument and accessories and/or subsequent restoration: Southeast Section Corner Section 12 (24-14) & Southwest Section Corner Section 7 (24-13) Set by John Brink in 1837.

- 1. Beech 12" in dia. S 43° W 09 links (5.94')
2. Hemlock 12" in dia. N 26° W 16 links (10.56')

Manistee County Surveyor's Records (undated)
Unknown surveyor, book A, page 264
Iron Stake Here.

Certificate of Survey by Harold Bruning, date unknown
Fd. 1/2" Iron Bar

- 3. Norway Maple 8" in dia. N 36° W 50'
4. Power pole S 80° W 22.28'

B. Description of corner evidence found and/or method applied in restoring or reestablishing corner: Southeast Section Corner Section 12 (24-14) & Southwest Section Corner Section 7 (24-13) On June 7, 2000, I, Anthony M. Slawinski along with a field crew from Abonmarche found a square nail flush with the asphalt over a 1/2" iron rod with an unreadable cap. We found no other evidence to dispute this location for the corner.

Condition of witnesses: #1 gone, #2 gone, #3 gone, #4 gone

C. Description of monument for corner and accessories established to perpetuate locating the position of the corner: Southeast Section Corner Section 12 (24-14) & Southwest Section Corner Section 7 (24-13) On June 7, 2000, I placed a Manistee County Monument, in a monument box in the exact location as the above mentioned 1/2" iron rod with unreadable cap as a careful and faithful re-establishment of the original corner, and witnessed by:


- 5. N 25° W 105.65' 15" Red Pine (fd. nail in S. side of tree)
6. S 36° W 56.28' 12" Ash (fd. 60d in S. side of tree)
7. S 25° E 91.00' 6" Poplar (set 60d in S. side of tree)
8. N 18° W 113.28' 13" Red Pine (set 60d in S. side of tree)

Corner is 2' South of centerline of Springdale Rd. in centerline of Thompsonville Rd.

Grid table with columns A-M and rows 1-13. Contains numerical data points for survey locations.

Corner M-05 ratified by the Manistee County Peer Group according to the county plan adopted pursuant to P.A. 345 of 1990, as amended, (being the State Survey and Monument Act, MCL 54.261 et. seq.). Date of Peer Review: 7-31-00

Anthony M. Slawinski

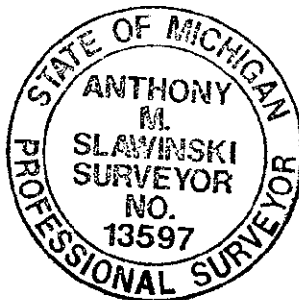

Signed by Anthony M. Slawinski
Surveyor's Michigan License No. 13597

Date 7-26-00