

OCT 03 2000

LAND CORNER RECORDATION CERTIFICATE
Filing Requirement of Act 74, Mich. P.A. 1970

SECTION

For corners in

Manistee (County) Located In: Corner Code #
1. Public Land Survey T 24N R 14W M-09 SE Sec Corner Sec 24
2. Property Controlling in Section S T R A-09 SW Sec Cor Sec 19
3. Miscellaneous Property in Sec. S T R
4. Lot No. , Recorded Plat
5. Private Claims

REGISTER'S OFFICE
MANISTEE COUNTY

00-307 at 11:50p.m
SEP 03 2000

Penny A. Repora
REGISTER OF DEEDS

Register of Deeds Stamp & File Number

I, Anthony M. Slawinski, in a field survey on June 2, 20 00 do hereby state that under requirements of P.A. 74, Michigan P.A. of 1970, the corner points mentioned in lines 1 and 2 above were in conformance with regulations and rules therefore as required in the current manual of survey instructions of the United States Department of the Interior, Bureau of Land Management or by a decree of a Court of Law and /or that the corner points mentioned in lines 3, 4 and 5 above were in conformance with the rules of the Michigan Board of Land Surveyors or by a Decree of a Court of Law; established, re-established, monumented, recovered, found as expressed below:

NOTE: Not more than 2 corners, all in the same town and range, may be recorded on this certificate.

A. Description of original monument and accessories and/or subsequent restoration: Southeast Section Corner Section 24 (24-14) & Southwest Section Corner Section 19 (24-13) Set by John Brink in 1837.

- 1. Beech 8" in dia. S 30° W 28 links (18.48')
2. Beech 12" in dia. N 47 1/2° W 42 links (27.72')

Land Corner Record by Kenneth Ostling RLS #10068, in 1960. (Rec. 70-34) Set 1" pipe with 4" brass cap by proportionate measurement between Section corners 1 mile North & 1 mile South

- 3. Black Cherry 12" in dia. S 55° E 114 links (75.24')
4. Black Cherry 14" in dia. S 53° W 141 links (93.06')

P.A. 74 form, by Larry M. Gerschbacher RLS #18990, in 1984. (Rec. 85-3) Fd. DNR disc and pipe.

- 3. Triple Cherry 15" in dia. S 54° E 75.44'
5. Twin Cherry 20" in dia. N 82° E 94.93'
4. Twin Cherry 18" in dia. S 52° W 94.47'


B. Description of corner evidence found and/or method applied in restoring or reestablishing corner: Southeast Section Corner Section 24 (24-14) & Southwest Section Corner Section 19 (24-13) On June 2, 2000, I Anthony M. Slawinski, along with a field crew from Abonmarche found a DNR disc and Pipe by a Carsonite Post. We found no other evidence to dispute this location for the corner.

Condition of witnesses: #1 gone, #2 gone, #3 good, #4 good & #5 good

C. Description of monument for corner and accessories established to perpetuate locating the position of the corner: Southeast Section Corner Section 24 (24-14) & Southwest Section Corner Section 19 (24-13) On June 2, 2000, I accepted the DNR disc and Pipe as a careful and faithful re-establishment of the position of the original corner, and witnessed by:

- 3. S 54° E 75.66' 34" Triple Cherry (set 60d on SW side of tree)
4. S 52° W 94.50' 30" Twin Cherry (set 60d on N side of tree)
5. N 82° E 94.52' 33" Twin Cherry (set 60d on S side of tree)
6. N 55° W 44.89' 12" Cherry (set 60d on W side of tree)

Corner is +/- 285' West of Thompsonville Rd.
Carsonite Post is 1' North

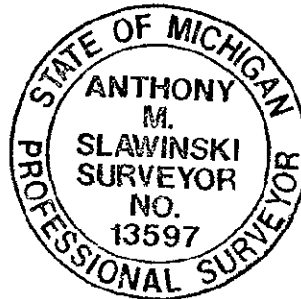

Signed by Anthony M. Slawinski
Surveyor's Michigan License No. 13597

Date 7-26-00


Corner M-D-9
according to the county plan adopted pursuant to P.A. 345 of 1990, as amended, (being the State Survey and Remonument Act, MCL 54.291 et seq.). Date of Peer Review: 7-31-00
Anthony M. Slawinski
ratified by the Manistee County Peer Group